

PIKE
C41
12-23-70

MISSISSIPPI
BOARD OF WATER COMMISSIONERS
416 North State Street
Jackson, Mississippi 39201

CODED

WATER WELL DRILLERS LOG

12-23 1970 date well completed
Fitzgerald Well Serv firm name
Pike county well located

LANDOWNER:
Charlie White
R. P. Ruth Miss.
(mailing address)

description of formations encountered	from	to
Red clay	6	22
Red sand	22	90
Coarse sandstone	90	120

WELL LOCATION: 02
sec 2 T 4 N R 9 E
6 miles N of Briceville
(distance) (direction) (nearest town)

WELL PURPOSE: Home
(home, irrigation, municipal, industrial)

- WELL COMPLETION DATA:
- (1) diameter (inches) 4
 - (2) total depth (feet) 120
 - (3) static water level (feet) 90 below top of ground.
 - (4) casing Plastic 114
(material) (depth)
4 if telescope see back.
(size)
 - (5) screen 6 114
(length) (depth to top)
4 Plastic
(size) (material)
 - (6) pump Buckett 1
(HP) (yield gpm)
Hand
(type power)
 - (7) electric log no
(yes or no)
 - (organization running log)
 - (8) how well bottom plugged wood plug

CODED


JAN 21 1971

DRILLERS REMARKS:

MISS. BD. OF
WATER COM.

If well telescopes please sketch and show depths.

GROUND LEVEL

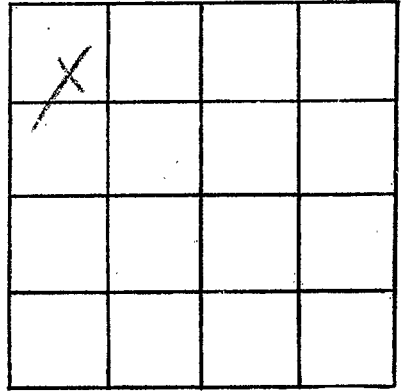

SECTION 2

Please indicate well location X.

ADDITIONAL INFORMATION

If more than one screen, show locations of each on sketch.