

PIKE  
C 42  
5-28-69

MISSISSIPPI  
BOARD OF WATER COMMISSIONERS  
416 North State Street  
Jackson, Mississippi 39201

**CODED**

WATER WELL DRILLERS LOG

May 28 1969 date well completed  
C. Kerner Well Drilling - Pike firm name  
Pike county well located

LANDOWNER: John W. Code  
RFD Hayes (mailing address)

WELL LOCATION:  
sec. 16 T 4 N R 9 E  
2 miles N (distance) (direction) (nearest town) *Friedale*

WELL PURPOSE: *Same*  
(home, irrigation, municipal, industrial)

- WELL COMPLETION DATA:
- (1) diameter (inches) 4"
  - (2) total depth (feet) 57
  - (3) static water level (feet) 4.5 below above top of ground.
  - (4) casing plastic ballam (material) (depth)
  - (size) If telescope see back.
  - (5) screen 6' 51' (length) (depth to top)
  - 4" (size) Plastic (material)
  - (6) pump 1/2 sub - 15 (HP) (yield gpm)
  - Geet (type power)
  - (7) electric log No (yes or no)
  - (organization running log)

description of formations encountered	from	to
<i>Sand</i>	<i>0</i>	<i>17</i>
<i>gravel &amp; sand</i>	<i>17</i>	<i>17</i>
<i>Blue chalk</i>	<i>17</i>	<i>24</i>
<i>fine sand</i>	<i>24</i>	<i>50</i>
<i>Red gravel</i>	<i>57</i>	<i>57</i>

**CODED**

AUG 15 1969


MISS. Bd. OF WATER COM. 1969

(8) how well bottom plugged wooden plug

DRILLERS REMARKS: board well  
contaminated

If well telescopes please sketch and show depths.

GROUND LEVEL

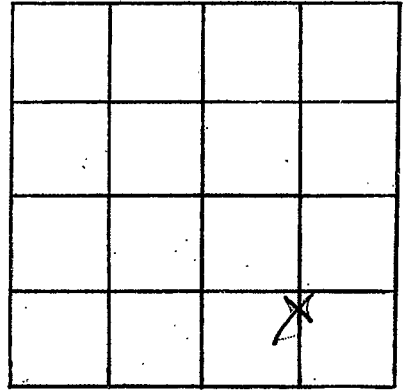

SECTION 16

Please indicate well location X.

ADDITIONAL INFORMATION

If more than one screen,  
show locations of each on sketch.