

MISSISSIPPI  
BOARD OF WATER COMMISSIONERS  
416 North State Street  
Jackson, Mississippi 39201

**CODED**

WATER WELL DRILLERS LOG

Pike  
C 43  
7-15-69

July 15, 1969 Reservoir Well Sample  
date well completed firm name county well located

LANDOWNER: J. C. Dickerson  
PFD  
Gaynes  
(mailing address)

WELL LOCATION:  
sec 20 T 4 N R 9 E  
2 1/2 miles N of Prichard  
(distance) (direction) (nearest town)

WELL PURPOSE: same  
(home, irrigation, municipal, industrial)

WELL COMPLETION DATA:  
(1) diameter (inches) 4"  
(2) total depth (feet) 150  
(3) static water level (feet) 105 below top of ground  
(4) casing Plastic bottom  
(size) If telescope see back.  
(5) screen 6' 144'  
(length) (depth to top)  
4" plastic  
(size) (material)  
(6) pump 1/2 HP 10  
(type power) (yield-gpm)  
Elect  
(7) electric log NO  
(yes or no)  
(organization running log)  
(8) how well bottom plugged  
wooden plug

description of formations encountered	from	to
Red clay	0	21
Red sand clay	21	72
Red sand gravel	72	88
Sandy sand	88	112
Red sand	112	140
Small gravel sand	140	150


**CODED**

DRILLERS REMARKS:  
old 7" well had

RECORDED  
7-15-69  
MISSISSIPPI BOARD OF WATER COMMISSIONERS

If well telescopes please sketch and show depths.

GROUND LEVEL

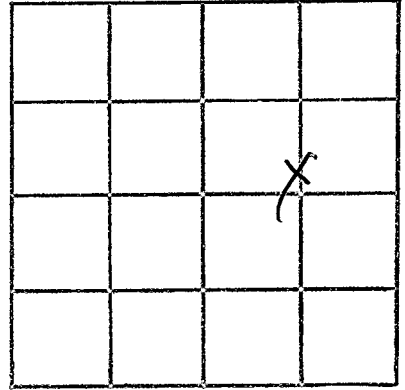

SECTION 10

Please indicate well location X.

ADDITIONAL INFORMATION

If more than one screen,  
show locations of each on sketch.