

Pike
C 44
8-27-69

MISSISSIPPI
 BOARD OF WATER COMMISSIONERS
 416 North State Street
 Jackson, Mississippi 39201

CODED

WATER WELL DRILLERS LOG

8-27 1969 Fitzgerald Well Sew Pike
 date well completed firm name county well located


LANDOWNER:	description of formations encountered	from	to
<u>Dick Watts</u>			
<u>R.R. Jayess, Miss.</u> (mailing address)	<u>Red Sand</u>	<u>20</u>	<u>50</u>
WELL LOCATION:	<u>Red Shale</u>	<u>50</u>	<u>80</u>
sec. <u>11</u> T. <u>4</u> N. R. <u>9</u> E	<u>Blue Sand</u>	<u>80</u>	<u>105</u>
<u>3</u> miles <u>N</u> of <u>Quindale</u>	<u>Coarse Sand & Gravel</u>	<u>105</u>	<u>126</u>
(distance) (direction) (nearest town)			
WELL PURPOSE: <u>Home</u> (home, irrigation, municipal, industrial)			
WELL COMPLETION DATA:			
(1) diameter (inches) <u>4</u>			
(2) total depth (feet) <u>126</u>			
(3) static water level (feet) <u>90</u> below top of ground.			
(4) casing <u>plastic</u> , <u>120</u> , (material) (depth)			
<u>4</u> if telescope see back. (size)			
(5) screen <u>6</u> , <u>120</u> (length) (depth to top)			
<u>4</u> , <u>plastic</u> (size) (material)			
(6) pump <u>1/2</u> , <u>10</u> (HP) (yield gpm)			
<u>Elec</u> (type power)			
(7) electric log <u>No</u> (yes or no)			
(organization running log)			
(8) how well bottom plugged <u>wood peg</u>			
DRILLERS REMARKS:			

CODED

5/2
 12 20 1969
 MISSISSIPPI
 BOARD OF WATER COMMISSIONERS
 JACKSON, MISSISSIPPI

If well telescopes please sketch and show depths.

GROUND LEVEL

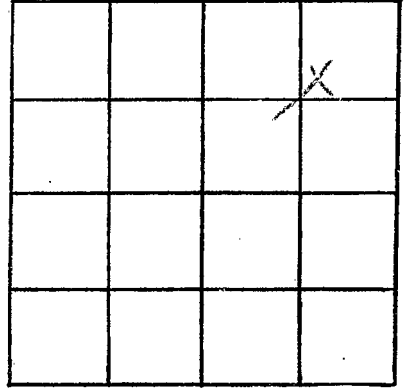

SECTION 11

Please indicate well location X.

ADDITIONAL INFORMATION

If more than one screen, show locations of each on sketch.