

MISSISSIPPI
BOARD OF WATER COMMISSIONERS
416 North State Street
Jackson, Mississippi 39201

CODED

WATER WELL DRILLERS LOG

Pike
C 45
10-2-69

10-2
date well completed

1969 Fitzgerald Well Dr
firm name

Pike
county well located

LANDOWNER:

Essa Rushing

RR Jayess Miss
(mailing address)

WELL LOCATION:

sec. 22 T. 4 N R. 9 E
S W
10 miles E of in Comb
(distance) (direction) (nearest town)

WELL PURPOSE: Home
(home, irrigation, municipal, industrial)

WELL COMPLETION DATA:

- (1) diameter (inches) 4
- (2) total depth (feet) 121
- (3) static water level (feet) 105 below above-top of ground.
- (4) casing Plastic, 113,
(material) (depth)
4 if telescope see back.
(size)
- (5) screen 8, 113
(length) (depth to top)
4, Plastic
(size) (material)
- (6) pump ?, ?
(HP) (yield gpm)
?
(type power)
- (7) electric log no
(yes or no)
(organization running log)
- (8) how well bottom plugged Cased by

description of formations encountered

from to

<u>Red clay</u>	<u>0</u>	<u>15</u>
<u>Red sand</u>	<u>15</u>	<u>75</u>
<u>Red gravel</u>	<u>75</u>	<u>113</u>
<u>Process sand & gravel</u>	<u>113</u>	<u>121</u>

CODED


DRILLERS REMARKS:

Oct. 20 1969

MISSISSIPPI
BOARD OF
WATER COMMISSIONERS

If well telescopes please sketch and show depths.

GROUND LEVEL

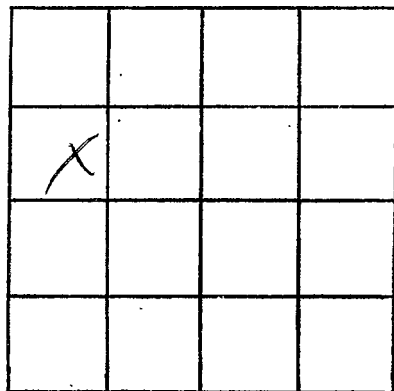

SECTION 22

Please indicate well location X.

ADDITIONAL INFORMATION

If more than one screen,
show locations of each on sketch.