

Pike  
C 46  
10-12-69

MISSISSIPPI  
BOARD OF WATER COMMISSIONERS  
416 North State Street  
Jackson, Mississippi 39201

**CODED**

WATER WELL DRILLERS LOG

10-12-69 date well completed      Fitzgerald Well Co firm name      Pike county well located

LANDOWNER:

P. Joe Felder  
RR. ~~1~~ 2, Min.  
(mailing address)

description of formations encountered

from to

Red clay	0	15
Red sand	15	80
white clay	80	100
loose sand & gravel	100	122

WELL LOCATION:

sec. 31 T. 4 N R. 9 E  
S W  
7 miles E of M'Comb  
(distance) (direction) (nearest town)

WELL PURPOSE: Home  
(home, irrigation, municipal, industrial)

WELL COMPLETION DATA:

- (1) diameter (inches) 4
- (2) total depth (feet) 122
- (3) static water level (feet) 60 below top of ground.
- (4) casing Plastic 114, (material) (depth)  
4 (size) if telescope see back.
- (5) screen 8, 122 (length) (depth to top)  
4 (size) plastic (material)
- (6) pump 1/2 12 (HP) (yield gpm)  
also (type power)
- (7) electric log no (yes or no)  
(organization running log)
- (8) how well bottom plugged wood peg

**CODED**


OCT 20 1969

MISS. Bd. of  
Water Comm.

DRILLERS REMARKS:

If well telescopes please sketch and show depths.

GROUND LEVEL

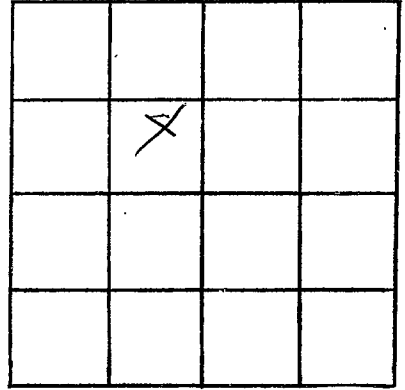

SECTION 21

Please indicate well location X.

ADDITIONAL INFORMATION

If more than one screen,  
show locations of each on sketch.