

PIKE
C 48
12-17-69

MISSISSIPPI
BOARD OF WATER COMMISSIONERS
416 North State Street
Jackson, Mississippi 39201

CODED

WATER WELL DRILLERS LOG


12-17-1969 *Fitzgerald Well Drilling* *Pike*
date well completed firm name county well located

LANDOWNER:	description of formations encountered	from	to
<i>Brester Brent</i> <i>RR. McComb, Miss.</i> (mailing address)	<i>Red clay</i> <i>Coarse sand & gravel</i>	<i>0</i> <i>15</i>	<i>25</i> <i>60</i>
WELL LOCATION: sec. <i>28</i> T <i>4</i> N R <i>9</i> E S W <i>9</i> miles <i>E</i> of <i>McComb</i> (distance) (direction) (nearest town)			
WELL PURPOSE: <i>Home</i> (home, irrigation, municipal, industrial)			
WELL COMPLETION DATA: (1) diameter (inches) <i>4</i> (2) total depth (feet) <i>60</i> (3) static water level (feet) <i>20</i> below top of ground. above (4) casing <i>Aluminum</i> <i>52</i> (material) (depth) <i>4</i> if telescope see back. (size) (5) screen <i>8</i> <i>52</i> (length) (depth to top) <i>4</i> <i>Aluminum</i> (size) (material) (6) pump <i>?</i> <i>?</i> (HP) (yield gpm) <i>Gas</i> (type power) (7) electric log <i>no</i> (yes or no) (organization running log) (8) how well bottom plugged <i>wood peg</i>			
DRILLERS REMARKS:			

CODED

DEC 22 1969

MISS. BD. OF
WATER COMMISSIONERS

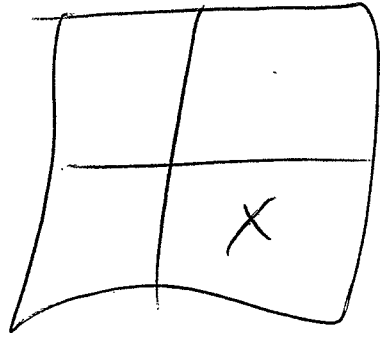

sec 28