

Pike
C 49
2-23-70

MISSISSIPPI
BOARD OF WATER COMMISSIONERS
416 North State Street
Jackson, Mississippi 39201

CODED

WATER WELL DRILLERS LOG

2-23 1970 Fitzgerald well dr Pike
date well completed firm name county well located

LANDOWNER:

Don Wilkinson

Rt 1 Myers, Miss
(mailing address)

WELL LOCATION:

sec. 21 T. 4 N. R. 9 E
1 miles N of Pineblake
(distance) (direction) (nearest town)

WELL PURPOSE: Home
(home, irrigation, municipal, industrial)

WELL COMPLETION DATA:

- (1) diameter (inches) 4
- (2) total depth (feet) 95
- (3) static water level (feet) 18 below above top of ground.
- (4) casing Plastic, 87,
(material) (depth)
4 if telescope see back.
(size)
- (5) screen 8, 87
(length) (depth to top)
4, Plastic
(size) (material)
- (6) pump 1/2, 15
(HP) (yield gpm)
Electric
(type power)
- (7) electric log yes
(yes or no)
(organization running log)
- (8) how well bottom plugged Good plug

description of formations encountered

from to

<u>Red Clay</u>	<u>0</u>	<u>15</u>
<u>Red gravel</u>	<u>15</u>	<u>30</u>
<u>White Clay</u>	<u>30</u>	<u>75</u>
<u>Fine sand</u>	<u>75</u>	<u>85</u>
<u>Coarse sand & gravel</u>	<u>85</u>	<u>95</u>

CODED


FEB 27 1970

MISS. BD. OF
WATER COM. L.

DRILLERS REMARKS:

If well telescopes please sketch and show depths.

GROUND LEVEL

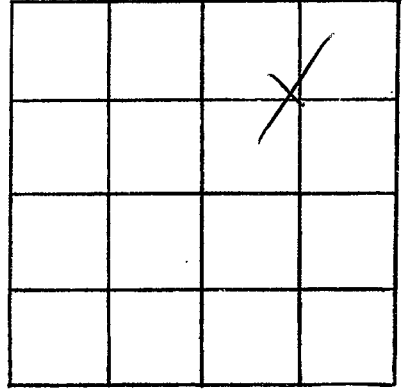

SECTION 21

Please indicate well location X.

ADDITIONAL INFORMATION

If more than one-screen,
show locations of each on sketch.