

PIKE  
C 50  
3-1-71

MISSISSIPPI  
BOARD OF WATER COMMISSIONERS  
416 North State Street  
Jackson, Mississippi 39201

**CODED**

WATER WELL DRILLERS LOG

3-1 1971 *Fitzgerald Well Dr* *Pike*  
date well completed firm name county well located

LANDOWNER:  
*Jewell M. Daniel*  
*P.R. Jones miss.*  
(mailing address)

description of formations encountered	from	to
<i>Red clay</i>	<i>12</i>	<i>23</i>
<i>Red shale</i>	<i>20</i>	<i>162</i>
<i>Coarse sand &amp; gravel</i>	<i>162</i>	<i>172</i>

WELL LOCATION:  
sec. *11* T. *4* N. R. *9* E  
*4* miles *N* of *Quibble*  
(distance) (direction) (nearest town)

WELL PURPOSE:  
*domestic*  
(home, irrigation, municipal, industrial)

- WELL COMPLETION DATA:
- (1) diameter (inches) *4*
  - (2) total depth (feet) *172*
  - (3) static water level (feet) *100* below above top of ground.
  - (4) casing *plastic* *164*  
(material) (depth)  
*4* if telescope see back.  
(size)
  - (5) screen *8* *164*  
(length) (depth to top)  
*4* *plastic*  
(size) (material)
  - (6) pump *3/4* *12*  
(HPY) (yield gpm)  
*elec*  
(type power)
  - (7) electric log *no*  
(yes or no)  
(organization running log)
  - (8) how well bottom plugged *wool m*

**CODED**


MAR 5 1971

MISSISSIPPI BOARD OF WATER COMMISSIONERS

DRILLERS REMARKS:

If well telescopes please sketch and show depths.

GROUND LEVEL

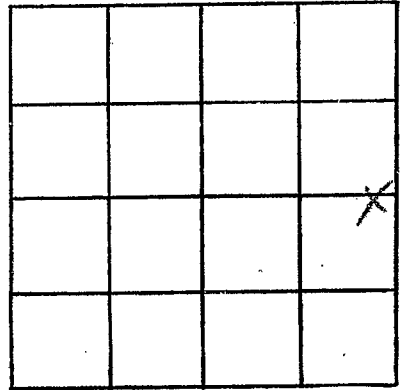

SECTION 14

Please indicate well location X.

ADDITIONAL INFORMATION

If more than one screen,  
show locations of each on sketch.