

PIKE
C 51
6-8-71

MISSISSIPPI
BOARD OF WATER COMMISSIONERS
416 North State Street
Jackson, Mississippi 39201

CODED

WATER WELL DRILLERS LOG

6-8 1971 St. James Well Co. Pike
date well completed firm name county well located

LANDOWNER:
A. B. Shelbald
RR, M. Comb, Miss.
(mailing address)

description of formations encountered	from	to
Red clay	0	20
Red sandstone	20	90
Red gravel	90	150
Coarse sandstone	150	163

WELL LOCATION:
sec. 33 T. 4 N. R. 9 E. U.R.
2 miles SW of Preville
(distance) (direction) (nearest town)

WELL PURPOSE:
Water
(home, irrigation, municipal, industrial)

- WELL COMPLETION DATA:
- (1) diameter (inches) 4
 - (2) total depth (feet) 163
 - (3) static water level (feet) 90 below above top of ground.
 - (4) casing galv 155
(material) (depth)
4 if telescope see back.
(size)
 - (5) screen 8 155
(length) (depth to top)
4 plastic
(size) (material)
 - (6) pump 1/2 10
(HP) (yield gpm)
Calor
(type power)
 - (7) electric log no
(yes or no)
(organization running log)
 - (8) how well bottom plugged alocly

CODED


JUN 14 1971

MISSISSIPPI
BOARD OF WATER COMMISSIONERS

DRILLERS REMARKS:

If well telescopes please sketch and show depths.

GROUND LEVEL

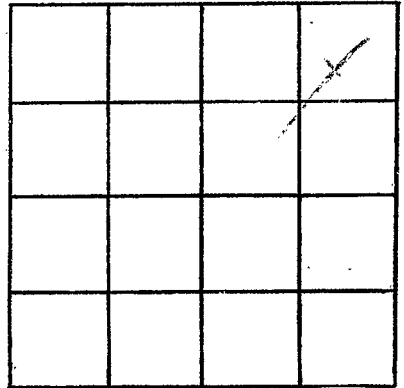

SECTION SW

Please indicate well location X.

ADDITIONAL INFORMATION

If more than one screen, show locations of each on sketch.