

MISSISSIPPI
BOARD OF WATER COMMISSIONERS
416 North State Street
Jackson, Mississippi 39201

CODED

WATER WELL DRILLERS LOG

PIKE
C 52
6-10-71

10/2nd 1971 J.T. Co. Inc. Pike
date well completed firm name county well located

LANDOWNER:
Leni Jenkins

(mailing address)

description of formations encountered	from	to
<u>Clay</u>	<u>0</u>	<u>20</u>
<u>Chalk</u>	<u>20</u>	<u>50</u>
<u>Chalk Sand</u>	<u>50</u>	<u>70</u>
<u>Chalk</u>	<u>70</u>	<u>90</u>
<u>Sand</u>	<u>90</u>	<u>132</u>

WELL LOCATION:
sec. 30 T4 N 9 E
S W
6 miles E of Smith
(distance) (direction) (nearest town)

WELL PURPOSE:
(home, irrigation, municipal, industrial)

- WELL COMPLETION DATA:
- (1) diameter (inches) 4
 - (2) total depth (feet) 132
 - (3) static water level (feet) 20 below above top of ground.
 - (4) casing PI 126
(material) (depth)
(size) if telescope see back.
 - (5) screen 6 126
(length) (depth to top)
4 PI
(size) (material)
 - (6) pump 1/2 8
(HP) (yield gpm)
elect
(type power)
 - (7) electric log NI
(yes or no)

(organization running log)
 - (8) how well bottom plugged wood

CODED


JUL 14 1971
JUL 14 1971

MISS. BD. OF
WATER COMM.

DRILLERS REMARKS:

If well telescopes please sketch and show depths.

GROUND LEVEL

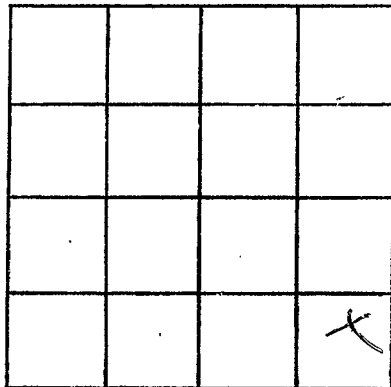

SECTION 22

Please indicate well location X.

ADDITIONAL INFORMATION

If more than one screen,
show locations of each on sketch.