

Pike  
C-53  
8-30-71

MISSISSIPPI  
BOARD OF WATER COMMISSIONERS  
416 North State Street  
Jackson, Mississippi 39201

**CODED**

WATER WELL DRILLERS LOG

8-30 1971 *Fitzgerald Well Serv* *Pike*  
date well completed firm name county well located

| LANDOWNER:  | description of formations encountered | from      | to         |
|---|---------------------------------------|-----------|------------|
| <i>Harvey Durbin</i>  |                                       |           |            |
| <i>RR. Lyleston Miss.</i><br>(mailing address)                                    | <i>Red clay</i>                       | <i>0</i>  | <i>20</i>  |
|   | <i>White clay</i>                     | <i>20</i> | <i>90</i>  |
|   | <i>Coarse sand &amp; gravel</i>       | <i>90</i> | <i>102</i> |
| WELL LOCATION:  |                                       |           |            |
| sec. <i>28 T 4 N S</i> R. <i>9 E</i>  |                                       |           |            |
| <i>8</i> miles <i>E</i> of <i>McComb</i><br>(distance) (direction) (nearest town) |                                       |           |            |
| WELL PURPOSE: <i>Home</i><br>(home, irrigation, municipal, industrial)            |                                       |           |            |
| WELL COMPLETION DATA:   |                                       |           |            |
| (1) diameter (inches) <i>4</i>  |                                       |           |            |
| (2) total depth (feet) <i>102</i>   |                                       |           |            |
| (3) static water level (feet) <i>30</i> Below above-<br>top of ground.            |                                       |           |            |
| (4) casing <i>Plastic 96</i><br>(material) (depth)                                |                                       |           |            |
| <i>4</i><br>(size) if telescope see back.   |                                       |           |            |
| (5) screen <i>6 96</i><br>(length) (depth to top)                                 |                                       |           |            |
| <i>4</i> <i>Plastic</i><br>(size) (material)                                      |                                       |           |            |
| (6) pump <i>1/2 12</i><br>(HP) (yield gpm)  |                                       |           |            |
| <i>Electric</i><br>(type power)   |                                       |           |            |
| (7) electric log <i>no</i><br>(yes or no)   |                                       |           |            |
| (organization running log)  |                                       |           |            |
| (8) how well bottom plugged <i>Wood plug</i>                                      |                                       |           |            |
| DRILLERS REMARKS:   |                                       |           |            |


**CODED**

SEP 15 1971

MISS. BUREAU OF  
WATER COMMISSIONERS

If well telescopes please sketch and show depths.

GROUND LEVEL

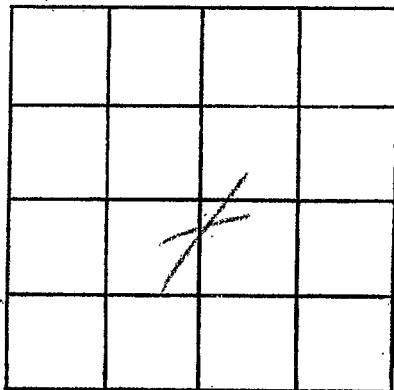

SECTION 28

Please indicate well location X.

ADDITIONAL INFORMATION

If more than one screen,  
show locations of each on sketch.