

MISSISSIPPI
BOARD OF WATER COMMISSIONERS
416 North State Street
Jackson, Mississippi 39201

WATER WELL DRILLERS LOG

CODED

Pike
C-54
6-11-71

June 11, 1971, Chester Keener, firm name, county well located

LANDOWNER: John Cade
D.F.D. Jaynes
(mailing address)

WELL LOCATION:
sec. 16 T. 4 N. R. 9 E
1 miles N of Pinedale
(distance) (direction) (nearest town)

WELL PURPOSE: Home
(home, irrigation, municipal, industrial)

- WELL COMPLETION DATA:
- (1) diameter (inches) 4"
 - (2) total depth (feet) 104
 - (3) static water level (feet) 15 below top of ground.
 - (4) casing (material) Plastic Bottom (depth)
 - (5) screen (length) 6' (depth to top) 98' (size) (material) Plastic
 - (6) pump 1/2 HP (type power) 15 (yield gpm) Slick
 - (7) electric log No (yes or no)
 - (8) how well bottom plugged wooden plug

description of formations encountered	from	to
Sandy clay	0	12
Yellow sand	12	57
White chalk	57	62
Sandy sand	62	95
Coarse white sand	95	104

CODED


SEP 17 1971

MISS. BD. OF
WATER COMMISSIONERS

DRILLERS REMARKS:
Shallow well insufficient

If well telescopes please sketch and show depths.

GROUND LEVEL

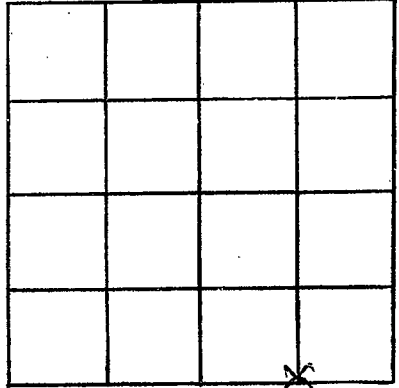

SECTION 26

Please indicate well location X.

ADDITIONAL INFORMATION

If more than one screen, show locations of each on sketch.