

Pike
 C55
 9-21-71

MISSISSIPPI
 BOARD OF WATER COMMISSIONERS
 416 North State Street
 Jackson, Mississippi 39201

CODED


WATER WELL DRILLERS LOG

9-21 date well completed 1971 *Fitzgerald Well Serv* firm name *Pike* county well located

LANDOWNER:	description of formations encountered	from	to			
<i>Robin C Nettles</i>	<i>Red Clay</i>	<i>12</i>	<i>20</i>			
<i>R.R. Jagers, Jr.</i> (mailing address)	<i>Red Sand</i>	<i>20</i>	<i>130</i>			
WELL LOCATION: sec. <i>2</i> T. <i>4</i> N. R. <i>9</i> E S	<i>Coarse Sand</i>	<i>130</i>	<i>144</i>			
<i>5</i> miles <i>N</i> of <i>Princeton</i> (distance) (direction) (nearest town)	CODED					
WELL PURPOSE: (home, irrigation, municipal, industrial)						
WELL COMPLETION DATA:						
(1) diameter (inches) <i>4</i>						
(2) total depth (feet) <i>144</i>						
(3) static water level (feet) <i>105</i> below above top of ground.						
(4) casing <i>Plastic</i> <i>136</i> (material) (depth)						
<i>4</i> (size) if telescope see back.						
(5) screen <i>8</i> <i>136</i> (length) (depth to top)						
<i>4</i> <i>Plastic</i> (size) (material)						
(6) pump <i>1</i> <i>4</i> (HP) (yield gpm)						
<i>Clay</i> (type power)						
(7) electric log <i>ny</i> (yes or no)						
(organization running log)						
(8) how well bottom plugged <i>wood plug</i>						
DRILLERS REMARKS:	<p style="text-align: right;">OCT 28 1971</p> <p style="text-align: right;">MISS. Bd. OF WATER COMMISSIONERS</p>					

If well telescopes please sketch and show depths.

GROUND LEVEL

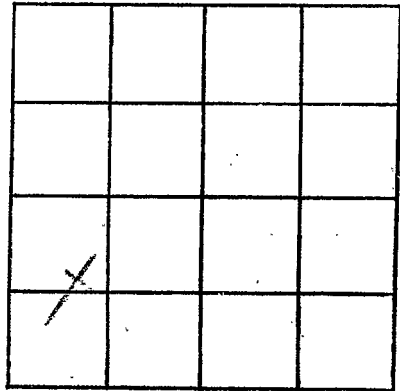

SECTION 2

Please indicate well location X.

ADDITIONAL INFORMATION

If more than one screen,
show locations of each on sketch.