

Pike
C 56
10-25-71

MISSISSIPPI
BOARD OF WATER COMMISSIONERS
416 North State Street
Jackson, Mississippi 39201

DEC 6 1971
CODED

WATER WELL DRILLERS LOG


25 Oct 1971 548 Waterwell Pike
date well completed firm name county well located

LANDOWNER:	description of formations encountered	from	to
William Alexandra Pinedale Miss (mailing address)			
WELL LOCATION: sec 28 T-4 N R-9 E 3 miles N Pinedale (distance) (direction) (nearest town)			
WELL PURPOSE: (home, irrigation, municipal, industrial)			
WELL COMPLETION DATA:			
(1) diameter (inches) 4 4			
(2) total depth (feet) 125			
(3) static water level (feet) 80 below above top of ground.			
(4) casing Pl 119 (material) (depth)			
(size) if telescope see back.			
(5) screen 6 119 (length) (depth to top)			
4 Pl (size) (material)			
(6) pump K 8 (HP) (yield gpm)			
Electric (type power)			
(7) electric log (yes or no)			
(organization running log)			
(8) how well bottom plugged <u>wood</u>			
DRILLERS REMARKS:			

CODED

If well telescopes please sketch and show depths.

GROUND LEVEL

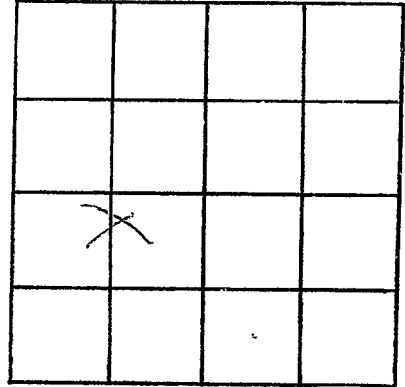

SECTION 2

Please indicate well location X.

ADDITIONAL INFORMATION

Lined area for additional information.

If more than one screen, show locations of each on sketch.