

Pike
 C 57
 9-13-71

MISSISSIPPI
 BOARD OF WATER COMMISSIONERS
 416 North State Street
 Jackson, Mississippi 39201

CODED

WATER WELL DRILLERS LOG

Sept 13 1971 date well completed
 Chester Keener firm name
 Pike county well located

LANDOWNER: North Pike
Jr High School
Rt 1, Summit
 (mailing address)

| description of formations encountered | from | to |
|---------------------------------------|------|-----|
| Red sandy clay | 0 | 10 |
| Red cherty sand | 10 | 60 |
| Red cherty gravel | 60 | 72 |
| Red shale | 72 | 86 |
| Red sand | 86 | 120 |
| Red sand gravel | 120 | 155 |
| Coarse sand gravel | 155 | 188 |

WELL LOCATION:
 sec 30 T 4 N R 9 E
2 1/2 miles SW of Prindab
 (distance) (direction) (nearest town)

WELL PURPOSE: school
 (home, irrigation, municipal, industrial)

- WELL COMPLETION DATA:
- (1) diameter (inches) 4"
 - (2) total depth (feet) 188
 - (3) static water level (feet) 111 below top of ground.
 - (4) casing plst bottom
 (material) (depth)
 - (size) If telescope see back.
 - (5) screen 10 178"
 (length) (depth to top)
 - 4" plst
 (size) (material)
 - (6) pump 1 1/2 30
 (HP) (yield gpm)
 - elect
 (type power)
 - (7) electric log no
 (yes or no)
 - (organization running log)


CODED

(8) how well bottom plugged wasn't plugged

DRILLERS REMARKS:
More water needed

If well telescopes please sketch and show depths.

GROUND LEVEL

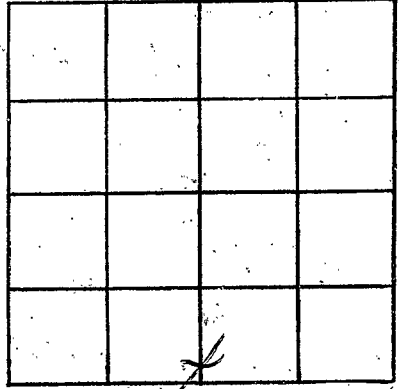

SECTION 30

Please indicate well location X.

ADDITIONAL INFORMATION

If more than one screen,
show locations of each on sketch.