

Pike
C 59
7-21-72

MISSISSIPPI
BOARD OF WATER COMMISSIONERS
416 North State Street
Jackson, Mississippi 39201

WATER WELL DRILLERS LOG

CODED

21 July 1972 date well completed
K.T. Compton firm name
Pike county well located

LANDOWNER:	description of formations encountered	from	to
Fred McGillock Pinedale (mailing address)	Clay Chalk Sand Chalk Sand	0 20 45 90 120	20 45 90 120 160
WELL LOCATION: sec. 19 T 4 N R 9 E 4 miles W of Pinedale (distance) (direction) (nearest town)			
WELL PURPOSE: (home, irrigation, municipal, industrial)			
WELL COMPLETION DATA:			
(1) diameter (inches) 4			
(2) total depth (feet) 160			
(3) static water level (feet) 80 below top of ground.			
(4) casing 21 (material), 154 (depth)			
_____ if telescope see back. (size)			
(5) screen 6 (length), 154 (depth to top)			
(6) pump 1/2 (HP), 8 (yield gpm)			
(7) electric log _____ (yes or no)			
_____ (organization running log)			
(8) how well bottom plugged _____			
DRILLERS REMARKS:			


CODED

OGT - 5 1972

MISS. BD. OF
WATER COM.

If well telescopes please sketch and show depths.

GROUND LEVEL

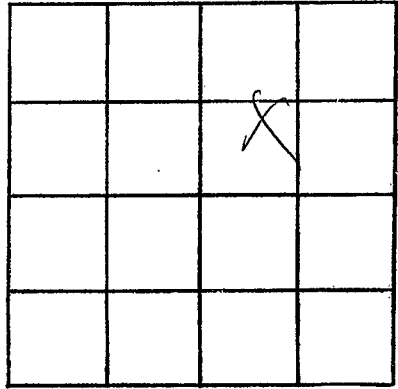

SECTION 19

Please indicate well location X.

ADDITIONAL INFORMATION

If more than one screen,
show locations of each on sketch.