

Pike
C 61
9-12-72

MISSISSIPPI
BOARD OF WATER COMMISSIONERS
416 North State Street
Jackson, Mississippi 39201
CODED
WATER WELL DRILLERS LOG

12 Sept 1972 J. T. Compton, Jr. Pike
date well completed firm name county well located

LANDOWNER:	description of formations encountered	from	to
Jerry Coon Pinedale (mailing address)			
WELL LOCATION:			
sec 24 T 4 N R 9 E 4 miles E of Pinedale (distance) (direction) (nearest town)			

WELL PURPOSE:
(home, irrigation, municipal, industrial)

- WELL COMPLETION DATA:
- (1) diameter (inches) 4
- (2) total depth (feet) 103
- (3) static water level (feet) 75 below above top of ground.
- (4) casing PI 97
(material) (depth)
- _____ if telescope see back.
(size)
- (5) screen 6 97
(length) (depth to top)
- 4 PI
(size) (material)
- (6) pump K 5
(HP) (yield gpm)
- Blut
(type power)
- (7) electric log _____
(yes or no)
- _____ (organization running log)
- (8) how well bottom plugged Wash

CODED


OCT 24 1972

DRILLERS REMARKS:

MISS. ED. OF
WATER COMMISSIONERS

If well telescopes please sketch and show depths.

GROUND LEVEL

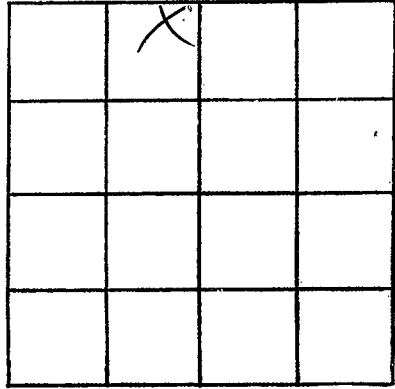

SECTION 24

Please indicate well location X.

ADDITIONAL INFORMATION

If more than one screen,
show locations of each on sketch.