

**MISSISSIPPI  
BOARD OF WATER COMMISSIONERS**  
416 North State Street  
Jackson, Mississippi 39201

**WATER WELL DRILLERS LOG**

**CODED**

Pike  
C64  
8-29-72

Aug 29 1972 Chotok Reeves Pike  
date well completed firm name county well located

LANDOWNER: Carl Felder  
Rt 2, Kothu

description of formations encountered	from	to
	clay	0
clay gravel	12	28
sand & gravel	28	47
white chalk	47	92
fine sand	92	126
coarse sand & gravel	126	144

(mailing address)

WELL LOCATION:  
sec 18 T 4 N R 9 E  
7 1/2 miles ENE Summit  
(distance) (direction) (nearest town)

WELL PURPOSE: Home  
(home, irrigation, municipal, industrial)

WELL COMPLETION DATA:

- (1) diameter (inches) 4"
- (2) total depth (feet) 144
- (3) static water level (feet) 67 below top of ground.
- (4) casing Plast bottom  
(material) (depth)
- (size) if telescope see back.
- (5) screen 6' 138'  
(length) (depth to top)
- 4" Plast  
(size) (material)
- (6) pump 1/2 HP 12  
(HP) (yield gpm)
- elect  
(type power)
- (7) electric log No  
(yes or no)

**CODED**

(organization running log)

(8) how well bottom plugged wooden plug


DRILLERS REMARKS:  
new location

DEC 1 1972

MISS. Bd. of  
WATER COMMISSIONERS

If well telescopes please sketch and show depths.

GROUND LEVEL

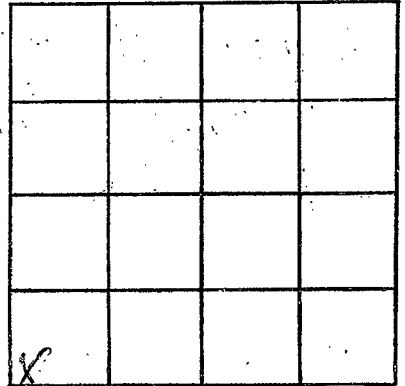

SECTION 18

Please indicate well location X.

ADDITIONAL INFORMATION

If more than one screen,  
show locations of each on sketch.