

Pike  
 C 67  
 1-30-73

MISSISSIPPI  
 BOARD OF WATER COMMISSIONERS  
 416 North State Street  
 Jackson, Mississippi 39201


WATER WELL DRILLERS LOG

30 June 1973 J.T. Carpenter Pipe date well completed firm name county well located

LANDOWNER:	description of formations encountered	from	to
Donald Howell Prichard, Miss (mailing address)	clay sand clay sand sand	0 10 35 60	10 25 60 70
WELL LOCATION: sec. 13 T. 4 N. R. 9 E 4 miles E of Prichard (distance) (direction) (nearest town)			
WELL PURPOSE: (home, irrigation, municipal, industrial)			
WELL COMPLETION DATA: (1) diameter (inches) 4 (2) total depth (feet) 70 (3) static water level (feet) 50 below top of ground. (4) casing (material) (depth) 4 (size) if telescope see back. (5) screen (length) (depth to top) 6 64 (size) (material) 4 (6) pump (HP) (yield gpm) 8 (type power) (7) electric log (yes or no) (organization running log) (8) how well bottom plugged well			
DRILLERS REMARKS:			

If well telescopes please sketch and show depths.

GROUND LEVEL

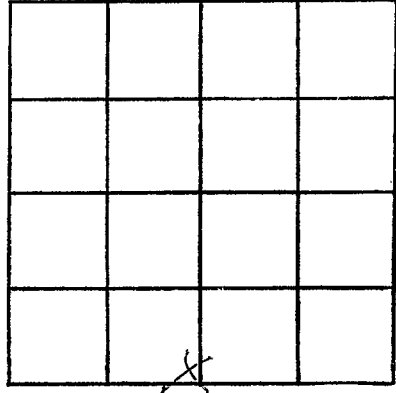

SECTION 13

Please indicate well location X.

ADDITIONAL INFORMATION

A series of horizontal lines for writing additional information.

If more than one screen, show locations of each on sketch.