

Pike
C 68
4-15-73

MISSISSIPPI
BOARD OF WATER COMMISSIONERS
416 North State Street
Jackson, Mississippi 39201

CODED

WATER WELL DRILLERS LOG

4-15 1973 Fitzgerald Well Dr Pike
date well completed firm name county well located

LANDOWNER:
Benny Quinn
RR. 1, Monticello, Miss.
(mailing address)

description of formations encountered	from	to
<u>red clay</u>	<u>0</u>	<u>20</u>
<u>peel sand</u>	<u>20</u>	<u>180</u>
<u>fine sand</u>	<u>180</u>	<u>190</u>
<u>coarse sand</u>	<u>190</u>	<u>200</u>

WELL LOCATION:
sec. 2 T. 4 N. R. 9 E
3 miles S of Pinebluff
(distance) (direction) (nearest town)

WELL PURPOSE:
Home
(home, irrigation, municipal, industrial)

- WELL COMPLETION DATA:
- (1) diameter (inches) 4
 - (2) total depth (feet) 200
 - (3) static water level (feet) 120 below above top of ground.
 - (4) casing plastic 192,
(material) (depth)
4 if telescope see back.
(size)
 - (5) screen 8, 192
(length) (depth to top)
4, plastic
(size) (material)
 - (6) pump 1/2 8
(HP) (yield gpm)
Electric
(type power)
 - (7) electric log no
(yes or no)
no
(organization running log)
 - (8) how well bottom plugged wood plug


CODED

DRILLERS REMARKS:

MISS. Bd. of
WATER COMMISSIONERS

If well telescopes please
sketch and show depths.

GROUND LEVEL

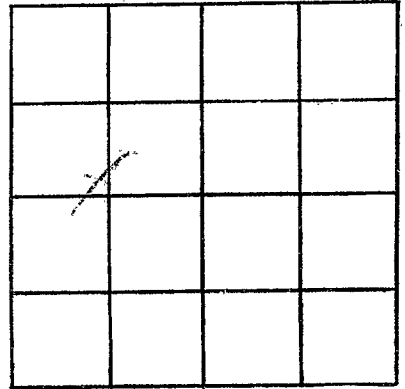

SECTION 2

Please indicate well location X.

ADDITIONAL INFORMATION

If more than one screen,
show locations of each on sketch.