

Pike
C 69
5-19-73

MISSISSIPPI
BOARD OF WATER COMMISSIONERS
416 North State Street
Jackson, Mississippi 39201

CODED

WATER WELL DRILLERS LOG

5-19 19 73 Flycatcher Well Inc Pike
date well completed firm name county well located

LANDOWNER:

Stanley Bayard
R.R. Summit Min.
(mailing address)

description of formations encountered

from

to

<u>Red Clay</u>	<u>0</u>	<u>20</u>
<u>Red Shale</u>	<u>20</u>	<u>45</u>
<u>White & Blue Clay</u>	<u>45</u>	<u>135</u>
<u>Coarse Sand</u>	<u>135</u>	<u>155</u>

WELL LOCATION:

sec 34 T. 4 S. R. 9 E.
2 miles S of Franklin
(distance) (direction) (nearest town)

WELL PURPOSE:

Home
(home, irrigation, municipal, industrial)

WELL COMPLETION DATA:

- diameter (inches) 4
- total depth (feet) 155
- static water level (feet) 70 below top of ground.
- casing plastic, 147
(material) (depth)
4 if telescope see back.
(size)
- screen 8, 147
(length) (depth to top)
4, plastic
(size) (material)
- pump 1/2, 10
(HP) (yield gpm)
elec
(type power)
- electric log no
(yes or no)
(organization running log)
- how well bottom plugged Wedg


CODED

DRILLERS REMARKS:

JUN 28 1973

If well telescopes please sketch and show depths.

GROUND LEVEL

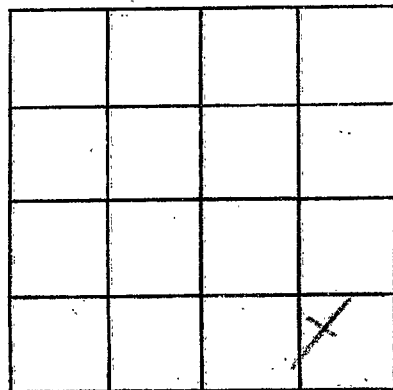

SECTION 34

Please indicate well location X.

ADDITIONAL INFORMATION

If more than one screen,
show locations of each on sketch.