

PIKE
C70
7-8-73

MISSISSIPPI
BOARD OF WATER COMMISSIONERS
416 North State Street
Jackson, Mississippi 39201

CODED

WATER WELL DRILLERS LOG

8541 1973 J.T. Livingston & Co. Pike
date well completed firm name county well located

LANDOWNER:
Erick Price
Piedall
(mailing address)

description of formations encountered	from	to
Clay	0	20
Chalk clay	20	50
Chalk	50	70
Sand	70	180
	180	208

WELL LOCATION:
sec 26 T 4 N R 9 E
3 miles E Piedall
(distance) (direction) (nearest town)

WELL PURPOSE:
(home, irrigation, municipal, industrial)

- WELL COMPLETION DATA:
- (1) diameter (inches) 4
 - (2) total depth (feet) 208
 - (3) static water level (feet) 202 below top of ground
 - (4) casing (material) PI (depth) 202
 - (size) If telescope see back.
 - (5) screen (length) 6 (depth to top) 202
 - (size) 4 (material) PI
 - (6) pump (HP) 1/2 (yield gpm) 8
 - (type power) 240v
 - (7) electric log (yes or no)
 - (organization running log)
 - (8) how well bottom plugged wood


CODED

DRILLERS REMARKS:

JUL 20 1973

If well telescopes please sketch and show depths.

GROUND LEVEL

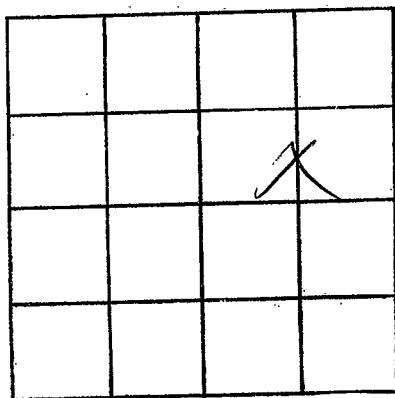

SECTION 26

Please indicate well location X.

ADDITIONAL INFORMATION

If more than one screen, show locations of each on sketch.