

CODED

MISSISSIPPI
BOARD OF WATER COMMISSIONERS
416 North State Street
Jackson, Mississippi 39201

WATER WELL DRILLERS LOG

PIKE
C 71
7-9-73

9 Jul

1973

J. T. Cooney

Pike

date well completed

firm name

county well located

LANDOWNER:

W. C. Jenkins
Summit
(mailing address)

description of formations encountered

from

to

clay 0 20
chert 20 60
sand 60 80
chert 80 28
sand 95 134

WELL LOCATION:

sec. 8 T 4 N R 9 E
2 miles N of Falkland
(distance) (direction) (nearest town)

WELL PURPOSE:

(home, irrigation, municipal, industrial)

WELL COMPLETION DATA:

- (1) diameter (inches) 4
- (2) total depth (feet) 134
- (3) static water level (feet) 80 below top of ground
- (4) casing (material) pl (depth) 128
(size) If telescope see back.
- (5) screen (length) 6 (depth to top) 128
(size) 4 (material) pl
- (6) pump (HP) 1/2 (yield gpm) 8
gled (type power)
- (7) electric log (yes or no)

CODED

(organization running log)


(8) how well bottom plugged wood

DRILLERS REMARKS:

JUL 20 1973

If well telescopes please sketch and show depths.

GROUND LEVEL

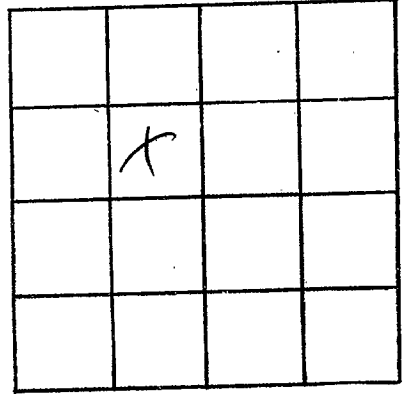

SECTION 2

Please indicate well location X.

ADDITIONAL INFORMATION

Lined area for additional information.

If more than one screen, show locations of each on sketch.