

PIKE

C74

2-25-74

MISSISSIPPI
 BOARD OF WATER COMMISSIONERS
 416 North State Street
 Jackson, Mississippi 39201

WATER WELL DRILLERS LOG

CODED

Feb 25 1974 F. L. General Well Service Pike
 date well completed firm name county well located

LANDOWNER:

Mr. Wilford Price

W. L. Jones
 (mailing address)

description of formations encountered

from

to

<u>Red clay</u>	<u>0</u>	<u>10</u>
<u>Red sand</u>	<u>10</u>	<u>60</u>
<u>Coarse sand & gravel</u>	<u>60</u>	<u>72</u>

WELL LOCATION:

sec 22 T 4 N

R 9 E

1/2 miles NE of Pinedale
 (distance) (direction) (nearest town)


WELL PURPOSE:

Home
(home, irrigation, municipal, industrial)

CODED

WELL COMPLETION DATA:

- (1) diameter (inches) 4
- (2) total depth (feet) 72
- (3) static water level (feet) 10 below top of ground.
- (4) casing Plastic, 64,
 (material) (depth)
4 if telescope see back.
 (size)
- (5) screen 8, 64
 (length) (depth to top)
4, Plastic
 (size) (material)
- (6) pump 1/2, 8
 (HP) (yield gpm)
elc
 (type power)
- (7) electric log no
 (yes or no)
 (organization running log)
- (8) how well bottom plugged sandstone

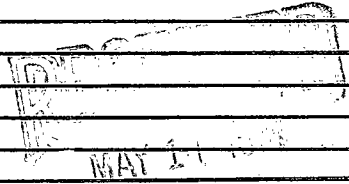


MISS. BD. OF WATER COMMISSIONERS

DRILLERS REMARKS:

If well telescopes please sketch and show depths.

GROUND LEVEL

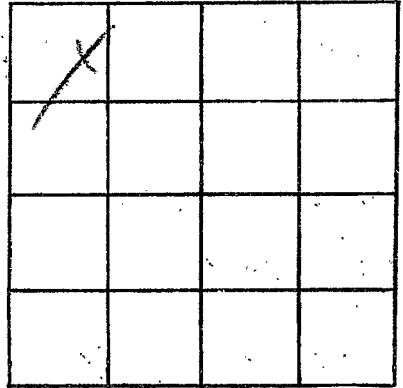

SECTION 27

Please indicate well location X.

ADDITIONAL INFORMATION

If more than one screen,
show locations of each on sketch.