

PIKE  
C 75  
2-20-74

MISSISSIPPI  
BOARD OF WATER COMMISSIONERS  
416 North State Street  
Jackson, Mississippi 39201 **CODED**  
WATER WELL DRILLERS LOG

70 Feb. 1974 Ames Park Wells Pike  
date well completed firm name county well located

LANDOWNER:  
Helen Felder  
Princeton  
(mailing address)

description of formations encountered	from	to
<u>clay</u>	<u>0</u>	<u>20</u>
<u>chert</u>	<u>20</u>	<u>65</u>
<u>red chert</u>	<u>65</u>	<u>90</u>
<u>grnd</u>	<u>90</u>	<u>134</u>

WELL LOCATION:  
sec. 18 T. 4 (N) R. 7 (E)  
2 miles S of Feldersville  
(distance) (direction) (nearest town)

WELL PURPOSE:  
(home, irrigation, municipal, industrial)

- WELL COMPLETION DATA:
- (1) diameter (inches) 4
  - (2) total depth (feet) 134
  - (3) static water level (feet) 75 below top of ground.
  - (4) casing 4 (material) 128 (depth)  
if telescope see back. (size)
  - (5) screen 6 (length) 128 (depth to top)  
4 (size) PI (material)
  - (6) pump 1/2 (HP) 8 (yield gpm)  
split (type power)
  - (7) electric log \_\_\_\_\_ (yes or no)  
(organization running log)
  - (8) how well bottom plugged wood


**CODED**

MISSISSIPPI BOARD OF WATER COMMISSIONERS

DRILLERS REMARKS: \_\_\_\_\_

If well telescopes please sketch and show depths.

GROUND LEVEL

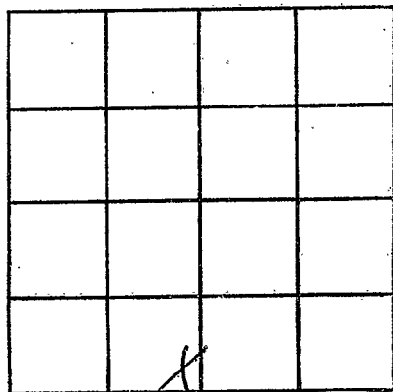

SECTION 18

Please indicate well location X.

ADDITIONAL INFORMATION

If more than one screen, show locations of each on sketch.