

PIKE
C 76
2-4-74


MISSISSIPPI
BOARD OF WATER COMMISSIONERS
416 North State Street
Jackson, Mississippi 39201
WATER WELL DRILLERS LOG

CODED

4 Feb. 74 19 St. Constantine Pike
date well completed firm name county well located

| LANDOWNER: | description of formations encountered | from | to |
|---|---|------------------------------------|-------------------------------------|
| <u>Fred McCallough</u> <u>Prindall</u> (mailing address) | <u>clay</u> <u>chert</u> <u>Sand Rock</u> | <u>0</u> <u>15</u> <u>45</u> | <u>15</u> <u>45</u> <u>74</u> |
| WELL LOCATION: sec <u>22</u> T <u>4</u> N R <u>9</u> E <u>1</u> miles <u>N</u> of <u>Prindall</u> (distance) (direction) (nearest town) | | | |
| WELL PURPOSE: (home, irrigation, municipal, industrial) | | | |
| WELL COMPLETION DATA: | | | |
| (1) diameter (inches) <u>4"</u> | | | |
| (2) total depth (feet) <u>74</u> | | | |
| (3) static water level (feet) <u>50</u> below above top of ground. | | | |
| (4) casing <u>PI</u> <u>68</u> (material) (depth) | | | |
| _____ if telescope see back. (size) | | | |
| (5) screen <u>6</u> <u>68</u> (length) (depth to top) | | | |
| <u>4</u> _____ (size) (material) | | | |
| (6) pump <u>1/2</u> <u>8</u> (HP) (yield gpm) | | | |
| <u>elect</u> (type power) | | | |
| (7) electric log _____ (yes or no) | | | |
| _____ (organization running log) | | | |
| (8) how well bottom plugged <u>wood</u> | | | |
| DRILLERS REMARKS: | | | |

CODED

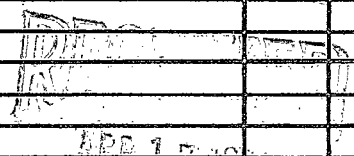


APR 17 1974

MISS. BLD. OF WATER COM.

If well telescopes please sketch and show depths.

GROUND LEVEL

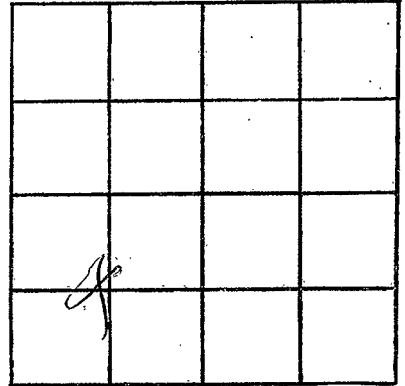

SECTION 22

Please indicate well location X.

ADDITIONAL INFORMATION

If more than one screen,
show locations of each on sketch.