

PIKE  
C 77  
7-19-74

MISSISSIPPI  
BOARD OF WATER COMMISSIONERS  
416 North State Street  
Jackson, Mississippi 39201

CODED

WATER WELL DRILLERS LOG

7-19 date well completed 19 74 firm name Fitzgerald Well Drilling county well located Pike

LANDOWNER:

Chester Boyal

RR Jones min  
(mailing address)

description of formations encountered

from

to

Red clay

0 20

Red sand

20 60

White chalk

60 125

Thin sand

125 145

Coarse sand & gravel

145 160

WELL LOCATION:

sec. 29 T 4 N R 9 E

2 1/2 miles W of Pineblake  
(distance) (direction) (nearest town)

WELL PURPOSE:

(home, irrigation, municipal, industrial) Home

WELL COMPLETION DATA:

- (1) diameter (inches) 4  
(2) total depth (feet) 160  
(3) static water level (feet) 110 below above top of ground.

(4) casing plastic, 152,  
(material) (depth)

4 if telescope see back.  
(size)

(5) screen 8, 152  
(length) (depth to top)

4, plastic  
(size) (material)

(6) pump 1/2 10  
(HP) (yield gpm)

1/2  
(type power)

(7) electric log no  
(yes or no)

(organization running log)

(8) how well bottom plugged Red shell


DRILLERS REMARKS:

REGISTERED  
MAY 26 1974

MISS. BD. OF W.A. 3 CO. VENEZ

If well telescopes please sketch and show depths.

GROUND LEVEL

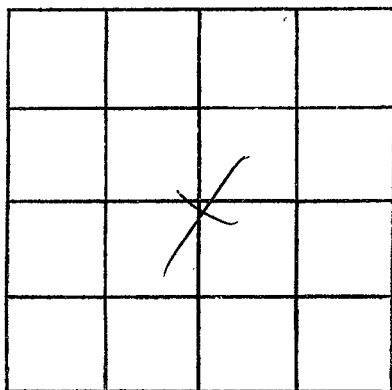

SECTION 29

Please indicate well location X.

ADDITIONAL INFORMATION

If more than one screen,  
show locations of each on sketch.