

C 80
 Pile
 5/14/75

MISSISSIPPI
 BOARD OF WATER COMMISSIONERS
 416 North State Street
 Jackson, Mississippi 39201

CODED

WATER WELL DRILLERS LOG


5-14 date well completed 19 75 *Fitzgerald* firm name *Pike* county well located

LANDOWNER:	description of formations encountered	from	to
<i>Roy Bister</i>			
<i>R.R. Jones, Miss</i> (mailing address)	<i>Red clay</i>	<i>0</i>	<i>20</i>
WELL LOCATION: sec. <i>14</i> T. <i>4</i> N. R. <i>9</i> E	<i>Red sand</i>	<i>20</i>	<i>115</i>
<i>2</i> miles <i>N</i> of <i>Carters Creek</i> (distance) (direction) (nearest town)	<i>Coarse sand</i>	<i>115</i>	<i>126</i>
WELL PURPOSE: <i>Home</i> (home, irrigation, municipal, industrial)			
WELL COMPLETION DATA:			
(1) diameter (inches) <i>4</i>			
(2) total depth (feet) <i>126</i>			
(3) static water level (feet) <i>80</i> below above top of ground.			
(4) casing <i>Plastic</i> , <i>118</i> (material) (depth)			
<i>4</i> If telescope see back. (size)			
(5) screen <i>8</i> , <i>118</i> (length) (depth to top)			
<i>4</i> , <i>Plastic</i> (size) (material)			
(6) pump <i>1/2</i> , <i>10</i> (HP) (yield gpm)			
<i>Electric</i> (type power)			
(7) electric log <i>No</i> (yes or no)			
(organization running log)			
(8) how well bottom plugged <i>Seal shot</i>			
DRILLERS REMARKS:			

REGISTERED
 JUN 10 1975
 MISS. Bd. OF WATER COMMISSIONERS

If well telescopes please sketch and show depths.

GROUND LEVEL

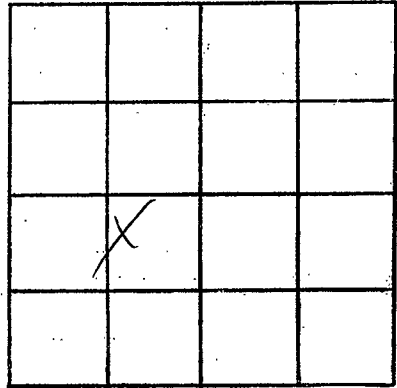

SECTION 14

Please indicate well location X.

ADDITIONAL INFORMATION

If more than one screen, show locations of each on sketch.