

C 81
 Pike
 4/22/75

MISSISSIPPI
 BOARD OF WATER COMMISSIONERS
 416 North State Street
 Jackson, Mississippi 39201

CODED

WATER WELL DRILLERS LOG

22 April 1975 - J.T. Long & Son Pike
 date well completed firm name county well located

LANDOWNER:
 Walter Bates
 Briceville
 (mailing address)

description of formations encountered	from	to
clay	0	25
red shale	25	60
red	60	107

WELL LOCATION:
 sec. 8 T. 4 N R. 9 E
 7 miles (distance) N of Tallahatchie (direction) (nearest town)

WELL PURPOSE:
 (home, irrigation, municipal, industrial)

WELL COMPLETION DATA:

(1) diameter (inches) 4

(2) total depth (feet) 107

(3) static water level (feet) 35 below above top of ground.

(4) casing (material) PL (depth) 108
 (size) if telescope see back.

(5) screen (length) 6 (depth to top) 108
 (size) 4 (material) PL

(6) pump (HP) 1/2 (yield gpm) 8
 (type power) sheet

(7) electric log (yes or no)

(organization running log)


(8) how well bottom plugged wood

RECEIVED
 JUN 6 1975
 MISS. BD. OF WATER COMMISSIONERS

DRILLERS REMARKS:

If well telescopes please sketch and show depths.

GROUND LEVEL

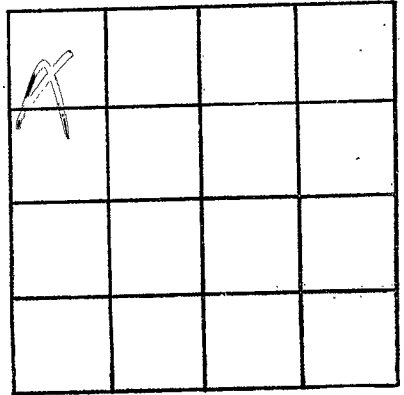

SECTION 1

Please indicate well location X.

ADDITIONAL INFORMATION

Lined area for additional information.

If more than one screen, show locations of each on sketch.