

Pike
C 82
8-6-75

MISSISSIPPI
 BOARD OF WATER COMMISSIONERS
 416 North State Street
 Jackson, Mississippi 39201

WATER WELL DRILLERS LOG

Aug 6 1975 Bennett Well Drilling Pike
 date well completed firm name county well located

LANDOWNER:
Mr. Curtis Green
Rt. Jayss
 (mailing address)

| description of formations encountered | from | to |
|---------------------------------------|------------|------------|
| <u>Red clay</u> | <u>0</u> | <u>10</u> |
| <u>sandy gravel</u> | <u>10</u> | <u>32</u> |
| <u>hard chalk</u> | <u>32</u> | <u>60</u> |
| <u>lumpy sand</u> | <u>60</u> | <u>104</u> |
| <u>sand & gravel</u> | <u>104</u> | <u>115</u> |

WELL LOCATION:
 sec. 27 T 4 N R. 9 E
in miles of Prudal
 (distance) (direction) (nearest town)

WELL PURPOSE: home
 (home, irrigation, municipal, industrial)

- WELL COMPLETION DATA:
- (1) diameter (inches) 4"
 - (2) total depth (feet) 115
 - (3) static water level (feet) 82 below top of ground.
 - (4) casing plastic bottom
 (material) (depth)
 - ✓ If telescope see back.
 (size)
 - (5) screen 6" 109'
 (length) (depth to top)
 - 4" plastic
 (size) (material)
 - (6) pump 1/2 sub 10
 (HP) (yield gpm)
 - elect
 (type power)
 - (7) electric log no
 (yes or no)
 - (organization running log)


(8) how well bottom plugged
wooden plug

DRILLERS REMARKS:
I well went bad

RECEIVED
 OCT 20 1975

If well telescopes please sketch and show depths.

GROUND LEVEL

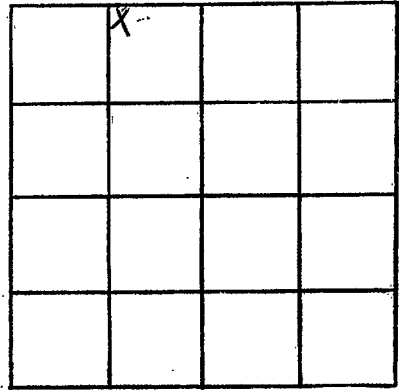

SECTION 27

Please indicate well location X.

ADDITIONAL INFORMATION

If more than one screen,
show locations of each on sketch.