

Pike
 C 83
 8-6-75

MISSISSIPPI
 BOARD OF WATER COMMISSIONERS
 416 North State Street
 Jackson, Mississippi 39201

WATER WELL DRILLERS LOG


Aug. 8 1975 Beau Well Drilling Pike
 date well completed firm name county well located

LANDOWNER:	description of formations encountered	from	to
<p>Mr. Emory Hem Rt. Jones (mailing address)</p>	<p>Clay sand Chalk - Pleistocene sand</p>	<p>0 30 102</p>	<p>30 102 120</p>
<p>WELL LOCATION: sec. <u>11</u> T. <u>4</u> N. R. <u>9</u> E <u>2 1/2</u> miles <u>north</u> of <u>Paicines</u> (distance) (direction) (nearest town)</p>			
<p>WELL PURPOSE: <u>home</u> (home, irrigation, municipal, industrial)</p>			
<p>WELL COMPLETION DATA:</p> <p>(1) diameter (inches) <u>4"</u></p> <p>(2) total depth (feet) <u>120</u></p> <p>(3) static water level (feet) <u>60</u> <small>below above</small> top of ground.</p> <p>(4) casing <u>plastic bottom</u> (material) (depth)</p> <p><u>1</u> If telescope see back. (size)</p> <p>(5) screen <u>6'</u> <u>114'</u> (length) (depth to top)</p> <p><u>4"</u> <u>plastic</u> (size) (material)</p> <p>(6) pump <u>3/4 HP</u> <u>6</u> (HP) (yield gpm)</p> <p><u>elect</u> (type power)</p> <p>(7) electric log <u>no</u> (yes or no)</p> <p>(organization running log)</p>			
<p>(8) how well bottom plugged <u>Washed plug</u></p> <p>DRILLERS REMARKS: <u>Pike well went dry</u></p>			

DECEMBER 1975
 OCT 20 1975

If well telescopes please sketch and show depths.

GROUND LEVEL

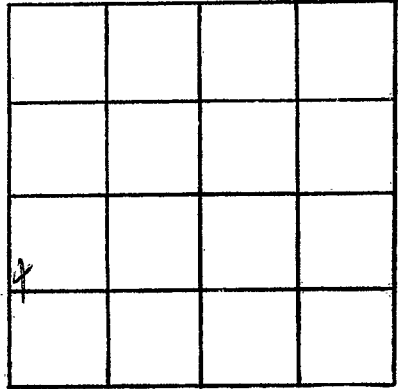

SECTION 11

Please indicate well location X.

ADDITIONAL INFORMATION

If more than one screen, show locations of each on sketch.