

MISSISSIPPI DEPARTMENT OF NATURAL RESOURCES

Bureau of Land and Water Resources

Southport Mall

CODED

P.O. Box 10631

Jackson, Mississippi 39209

WATER WELL DRILLERS LOG

C 86
PIKE
5-2-84

5-2-84 19
date well completed

F. Gerald Well Sew
firm name

Pike
county well located

LANDOWNER:	description of formations encountered	from	to
<i>Bobby Nelson</i>	<i>Red clay</i>	<i>0</i>	<i>20</i>
<i>BB. Summit, ms.</i> (mailing address)	<i>Red sand</i>	<i>20</i>	<i>102</i>
WELL LOCATION: sec. <i>2</i> T <i>4</i> N R <i>9</i> E <i>3</i> miles <i>NNW</i> of <i>Felders</i> (distance) (direction) (nearest town)	<i>Coarse sandstone</i>	<i>102</i>	<i>120</i>
WELL PURPOSE: <i>Home</i> (home, irrigation, municipal, industrial)			
WELL COMPLETION DATA: (1) diameter (inches) <i>4</i> (2) total depth (feet) <i>120</i> (3) static water level (feet) <i>50</i> below above top of ground. (4) casing <i>PVC 112</i> , (material) (depth) <i>4</i> if telescope see back. (size) (5) screen <i>8</i> , <i>112</i> (length) (depth to top) <i>4</i> , <i>PVC</i> (size) (material) (6) pump <i>1/2</i> , <i>10</i> (HP) (yield gpm) <i>Elec</i> (type power) (7) electric log <i>No</i> (yes or no) (organization running log) (8) how well bottom plugged <i>Sand Shk</i>			
DRILLERS REMARKS:			


DEPT. OF NATURAL RESOURCES
BUREAU OF LAND & WATER RESOURCES

JUN 15 1984

RECEIVED

If well telescopes please sketch and show depths.

GROUND LEVEL

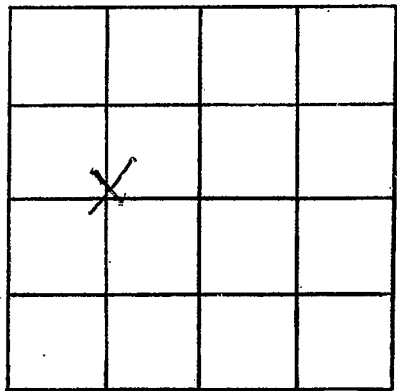

SECTION 7

Please indicate well location X.

ADDITIONAL INFORMATION

If more than one screen,
show locations of each on sketch.