

MISSISSIPPI DEPARTMENT OF NATURAL RESOURCES

Bureau of Land and Water Resources

Southport Mall

P.O. Box 10631

Jackson, Mississippi 39209

WATER WELL DRILLERS LOG

CODED

C. 88
PIKE
11-30-84

11-30-84 Griner Drilling Service, Inc.

Pike

date well completed

firm name

county well located

LANDOWNER:
Cities Service Oil & Gas
P.O. Box 12026
Jackson, Ms. 39211
(mailing address)

description of formations encountered

from

to

sand, pea gravel

0

110

clay

110

300

WELL LOCATION: 330' N + 1323' W

sec. 31 T. 4 N R. 9 E SE/40

No. 1 Felder A miles Holmesville
(distance) (direction) (nearest town)

CODED

WELL PURPOSE: oil field supply
(home, irrigation, municipal, industrial)

WELL COMPLETION DATA:

- (1) diameter (inches) 6"
- (2) total depth (feet) 300'
- (3) static water level (feet) 23' below top of ground.

(4) casing Steel 90'
(material) (depth)
6"
(size) if telescope see back.

(5) screen 20' 70'
(length) (depth to top)
6" stainless
(size) (material)

(6) pump 10 150-200
(HP) (yield gpm)
480 volt + 3 phase
(type power)

(7) electric log (yes or no)
(organization running log)


(8) how well bottom plugged 4"
back wash valve

DRILLERS REMARKS:

DEPT. OF NATURAL RESOURCES
BUREAU OF LAND & WATER RESOURCES
DEC 19 1984
RECEIVED

②
If well telescopes please
sketch and show depths.

GROUND LEVEL

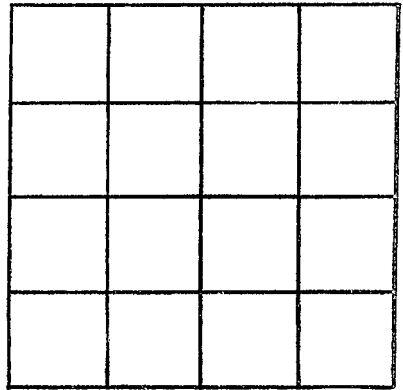

SECTION _____

Please indicate well location X.

ADDITIONAL INFORMATION

If more than one screen,
show locations of each on sketch.