

**MISSISSIPPI DEPARTMENT OF NATURAL RESOURCES**  
 Bureau of Land and Water Resources  
 Southport Mall  
 P.O. Box 10631  
 Jackson, Mississippi 39209  
**WATER WELL DRILLERS LOG**

PIKE
C89
4-26-85

4-26 1985 Fitzgibbon Well Serv Pike  
 date well completed firm name county well located


LANDOWNER:	description of formations encountered	from	to
<u>Robbie McCallough</u>			
<u>RR-1 Jones, ms.</u> (mailing address)	<u>Red Clay</u>	<u>0</u>	<u>20</u>
	<u>Red Sand</u>	<u>20</u>	<u>95</u>
	<u>Coarse Sandstone</u>	<u>95</u>	<u>108</u>
WELL LOCATION:			
sec. <u>32</u> T <u>4</u> (N) S R <u>9</u> (E) W			
<u>1</u> miles <u>W</u> of <u>TOPISAW</u> (distance) (direction) (nearest town)			
WELL PURPOSE: (home, irrigation, municipal, industrial)			
<u>Home</u>			
WELL COMPLETION DATA:			
(1) diameter (inches) <u>4</u>			
(2) total depth (feet) <u>108</u>			
(3) static water level (feet) <u>65</u> below top of ground.			
(4) casing <u>PVC</u> , <u>98</u> (material) (depth)			
<u>4</u> (size) if telescope see back.			
(5) screen <u>10</u> , <u>98</u> (length) (depth to top)			
<u>4</u> , <u>PVC</u> (size) (material)			
(6) pump <u>1/2</u> , <u>10</u> (HP) (yield gpm)			
<u>Electric</u> (type power)			
(7) electric log <u>No</u> (yes or no)			
(organization running log)			
(8) how well bottom plugged <u>Sealed</u>			

**RECEIVED**  
 MAY 17 1985

DRILLERS REMARKS: \_\_\_\_\_  
 Department of Natural Resources  
 Bureau of Land & Water Resources

If well telescopes please sketch and show depths.

GROUND LEVEL

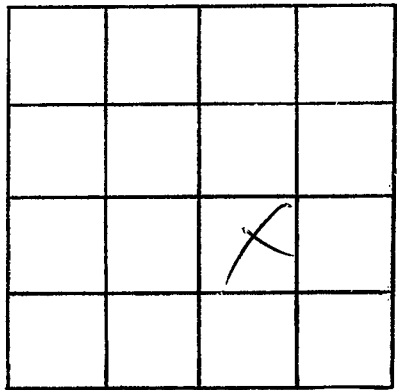

SECTION 22

Please indicate well location X.

ADDITIONAL INFORMATION

If more than one screen, show locations of each on sketch.