

MISSISSIPPI DEPARTMENT OF NATURAL RESOURCES
 Bureau of Land and Water Resources
 Southport Mall
 P.O. Box 10631
 Jackson, Mississippi 39209
WATER WELL DRILLERS LOG

PIKE
C90
4-17-85

4-17 1985 Fitzgibbon & Co Pike
 date well completed firm name county well located

LANDOWNER:	description of formations encountered	from	to
<u>Gary Dorsworthy</u>	<u>Red clay</u>	<u>0</u>	<u>20</u>
<u>R.R. 1 Jones, Mrs.</u> (mailing address)	<u>Red sand</u>	<u>20</u>	<u>120</u>
WELL LOCATION:	<u>Coarse sand & gravel</u>	<u>120</u>	<u>136</u>
sec. <u>15</u> T. <u>4</u> (N) S. R. <u>9</u> (E) W.			
<u>2</u> miles <u>N</u> of <u>Friendship</u> (distance) (direction) (nearest town)			
WELL PURPOSE: <u>Domestic</u> (home, irrigation, municipal, industrial)			
WELL COMPLETION DATA:			
(1) diameter (inches) <u>4</u>			
(2) total depth (feet) <u>136</u>			
(3) static water level (feet) <u>58</u> below above top of ground.			
(4) casing <u>PVC</u> , <u>126</u> , (material) (depth) <u>4</u> if telescope see back. (size)			
(5) screen <u>10</u> , <u>126</u> (length) (depth to top) <u>4</u> (size) <u>PVC</u> (material)			
(6) pump <u>3/4</u> , <u>15</u> (HP) (yield gpm) <u>elec</u> (type power)			
(7) electric log <u>no</u> (yes or no) <u>no</u> (organization running log)			
(8) how well bottom plugged <u>plugged</u>			
DRILLERS REMARKS:			


RECEIVED

MAY 17 1985

Department of Natural Resources
 Bureau of Land & Water Resources

If well telescopes please sketch and show depths.

GROUND LEVEL

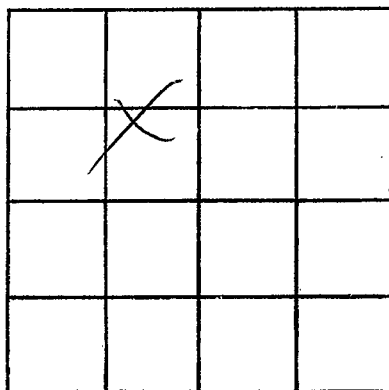

SECTION 15

Please indicate well location X.

ADDITIONAL INFORMATION

If more than one screen,
show locations of each on sketch.