STATE	WELL REPORT	
County: like	Part 1	For Office Use Only:
1	Driller's Log	Well #: <u>U138</u>
Permit #: Mississippi Depar	tment of Environmental Quality and and Water Resources	Aquifer:
	P.O. Box 2309	E-Log #:
Date drilling completed: <u><i>F-F-I</i></u> Jack	son, MS 39225-2309 (601)961-5210	
(6	01)360-0535 (fax)	
State Law requires that this report be prepared by the Department at the above address within 30 days of co		
Well Owner Information		hole Location
(Landowner if borehole is not for a water well)	Latitude: 3/0/2'3" Lor	ngitude: <u>FO^O LF 30, 2"</u>
Owner Name: Olu Dumcun	Nothed of Lat /Long (check one): Conventional Survey,
Mailing Address: 1444		
/	USGS quad, Hand-held G	
M Your h ms	<u>SW 14 NW 14, Sec</u>	29 T. YN R. 9E
M (lum b)M SCityStateZip Code	Mileso (Distance) (Direction)	
Telephone No. ()	(Distance) (Direction)	(Nearest Town)
	Borehole Data	
Date drilling started: $\underline{F:F:13}$. Date drilling completed Location of the source of any surface water used for drill Method of dosing and volume of Chlorine used in drilling	ing:and development:	
Logs run (circle all applicable): No log-run Electric Gam		on Other:
Name of organization running log(s):		
Purpose of borehole (circle one): Water Well Geotechi	nical/Geological Investigation	Ground Source Heat Pump
	(describe)	
If drilling is not related to water well	construction, skip the remainder	of this block
Purpose of Well (circle all applicable): Home Industrial	Public Supply Irrigation	Fish Culture
Other (describe):		
If a flowing well, method of flow regulation: Valve	Other (describe)	······································
Static Water Level: <u>65</u> feet [above or belo (circle one)	w] land surface Date measured	d: <u>\$-\$-13</u> ,
Method of measurement (circle one): Stoel tape Electric	-	_
Well depth: 127^{-1} Well grouted to a depth of: <u>10^{-10}</u>		
Casing length: _//?´feet Casing diameter:	<u>Y</u> inches Type of a	casing: Avc
Screen length: 10 feet Screen diameter:	Y inches Type of	screen: Pro
Screen slot size: <u>010</u> inches Setting dept	h: From <u>117</u> feet to	pfeet
Type of completion (circle all applicable): Gravel packed	Underreamed Open hole	Natural Development
Other (describe):	······································	BY THIMP
Top of lap pipe or reduction in casing:feet	:	化甲基甲基化物酶医骨酸过度 计
If telescoped or more than	one screen, describe on next pa	ge


• ·

County: _	Pitte
Permit #:	

For	Office	Use	Only:

The sketch below only required for water wells

If well telescopes, show depths on sketch.

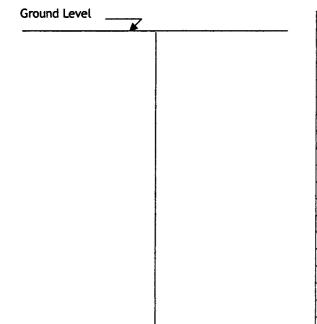

Description of formations encountered must be provided for all wells and boreholes, unless specifically exempted by regulations

Description of Formations Encountered	From (depth)	To (depth)
	Ground level	
Cluy- chuch Sand Cluy- Sand Cause Sand	C	20
chuck	20	40
Sand	40	FO
Cluz-	80	100
Sand	100	110
(coude Sand	110	127
· · · · · · · · · · · · · · · · · · ·		
······		

If more than one screen, show location of each on sketch

Sketch the property layout and include the following:

1) the well location

2) any permanent structures on the property that may aid in locating the well
3) any roads, power lines, or other items that may aid in locating the property and the well

4) north arrow		thuse well,	et topsurge	
Lu~	Huy 44	/	3	Ę
Landowner Name:	Bun (an), ell/borebole was drilled con	structed and completed	in accordance wi	th all applicable
requirements of the Mississip if applicable, and state laws. $\frac{BiAdia - 2eald}{Print Name of Responsible Lie$	pi Department of Environmer	The Date of the Missi	Signature of	t of Health regulations,

Form: OLWR-SWR-1A (4/13)

	STATE WELL REPORT	
County: Pike	Part 2	For Office Use Only:
Permit #:	Pump Installer's Completion Report	
Driller: Thend will fear	Mississippi Department of Environmental Quality Office of Land and Water Resources	Well #: <u>U138</u>
Date completed:	P.O. Box 2309	
Copy information from block on Part 1	Jackson, MS 39225-2309 (601)961-5210	Aquifer:
	(601) 360-0535 (fax)	
This part of the report must be complete of the report must be attached and both	d by a licensed water well contractor or a licensed pur parts filed with the Department at the above address w	np installer. A copy of Part 1
Well Owner Informati		ocation
Owner Name: Opal Duncu	<u>и.</u> Latitude: <u>31° 17´3."</u> Lon	gitude: 40° 18' 30,2"
Owner Name: Opal Buncu Mailing Address: <u>Huy 44</u> ,	Method of Lat/Long (check one)	
	USGS quad, Hand-held Gi	
Million by MS.		29 TUN DGE
<u>Milcanb</u> MS. City State	Zip Code	-1
Telephone No. ()	Miles of of Of	29 T_YN_R_GE Nearest Town)
	Pump Type (circle one)	······································
Submersible Turbine Air Lift Centrif	ugal Flowing Well Jet Piston Rotary Other (de	scribe):
Date Pump Installed: 8-8-13.	Rated Pump Capacity: <u>12-</u>	Gallons Per Minute
Is This Pump (circle one): (New) Rep		
	Power Type (circle one)	
Electric Diesel Gasoline Natural Gas	Tractor PTO Windmill Other (<i>describe</i>):	
	Setting Depth: <u>105</u> feet Number	
	Pump Test Data for Non Flowing Well	
Date Well Tested:	Duration of Pump Test (minime	um 4 hours): hours
Static Water Level (A): Feet	t Below Land Surface Pumping Water Level (B):	Feet Below Land Surface
Drawdown [(B) - (A)]:	Feet Below Land Surface Test Pumping Rate:	Gallons Per Minute
Method of measurement (circle one): St	eel tape Electric tape Air line Other (<i>describe</i>):_	
	Pump Test Data for Flowing Well	
Measured shut in head:feet.		
Well yieldedGPM with a d	rawdown of feet after	hours of pumping
	Meter Installation	
Meter Manufacturer:		والمروار والمحمور المرومون والمحمور والمروار والمروار والمروار
	Type of Meter:	and pred there is a series of the
	actor (AF x .001, gal x 1000, etc):	
	Neter installed by:	
Is This Meter (<i>circle one</i>): New Repaired Replacement		HAN OF WE
Important: By submitting the above inj For agricultur	formation you are certifying that this meter was install ral wells, a list of approved meters is on the MDEQ we	led to manufacturer standards. bsite.
	nents are true to the best of my knowledge. /	
0 1 - 6 11	a littl	
BIAC FLY gene 1 029. Print Name of Pump Installer and Licens	8-8-13, /Ed. 100	/
Print Name of Pump Installer and License	e No. (if applicable) Date Signati	ure of Pump Installer

Form: OLWR-SWR-1B (4/13)
-------------------------	---