

Pike
C 2000
9-8-75

MISSISSIPPI
BOARD OF WATER COMMISSIONERS
416 North State Street
Jackson, Mississippi 39201

WATER WELL DRILLERS LOG

Pike
~~_____~~

Sept 8 1975 *Revere Well Serv* ~~_____~~
date well completed firm name county well located

LANDOWNER:
Willie Dawson
Rt. Ruth Miss
(mailing address)

description of formations encountered	from	to
<i>Red Clay</i>	<i>0</i>	<i>20</i>
<i>Red sand</i>	<i>20</i>	<i>53</i>
<i>White sand</i>	<i>53</i>	<i>80</i>
<i>Red Chalk</i>	<i>80</i>	<i>120</i>
<i>Sand & Gravel</i>	<i>120</i>	<i>136</i>

WELL LOCATION:
sec. *19* T *4* N R *9* E
2 1/2 miles *W. N.W.* of *Princeton*
(distance) (direction) (nearest town)

WELL PURPOSE: *Home*
(home, irrigation, municipal, industrial)

- WELL COMPLETION DATA:
- (1) diameter (inches) *4"*
 - (2) total depth (feet) *136*
 - (3) static water level (feet) *105* below/above top of ground.
 - (4) casing *Plastic Cotton*
(material) (depth)
 - _____ If telescope see back.
(size)
 - (5) screen *6'* *130*
(length) (depth to top)
 - 2 1/2"* *Plastic*
(size) (material)
 - (6) pump *1/2* *10*
(HP) (yield gpm)
 - split*
(type power)
 - (7) electric log *no*
(yes or no)
 - _____ (organization running log)

(8) how well bottom plugged
W. address plug


DRILLERS REMARKS:
New house location

RECEIVED

JAN 2 1976

If well telescopes please sketch and show depths.

GROUND LEVEL

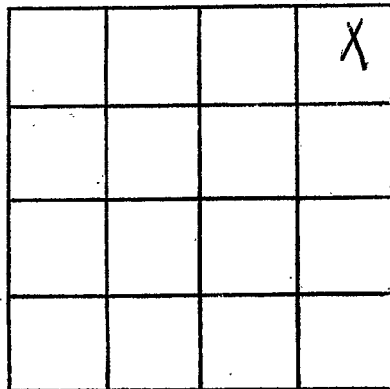

SECTION 19

Please indicate well location X.

ADDITIONAL INFORMATION

If more than one screen, show locations of each on sketch.