

Pike  
C 2001  
12-3-75

MISSISSIPPI  
 BOARD OF WATER COMMISSIONERS  
 416 North State Street  
 Jackson, Mississippi 39201

WATER WELL DRILLERS LOG

12-3 1975 Fitzgerald Well Sew Pike  
 date well completed firm name county well located

LANDOWNER:  
Jerry Bowman  
R.R. Jones, Miss  
 (mailing address)

description of formations encountered	from	to
<u>Red clay</u>	<u>0</u>	<u>20</u>
<u>Red sand</u>	<u>20</u>	<u>75</u>
<u>Red &amp; white clay</u>	<u>75</u>	<u>104</u>
<u>Coarse sand &amp; gravel</u>	<u>104</u>	<u>115</u>

WELL LOCATION:  
 sec. 22 T. 4 N. R. 9 E  
1 miles E of Princeton  
 (distance) (direction) (nearest town)

WELL PURPOSE: Home  
 (home, irrigation, municipal, industrial)

- WELL COMPLETION DATA:
- (1) diameter (inches) 4
  - (2) total depth (feet) 115
  - (3) static water level (feet) 60 below top of ground.
  - (4) casing PVC, 107,  
 (material) (depth)  
4 if telescope see back.  
 (size)
  - (5) screen 8, 107  
 (length) (depth to top)  
4, PVC  
 (size) (material)
  - (6) pump 1/2, 10  
 (HP) (yield gpm)  
elec  
 (type power)
  - (7) electric log No  
 (yes or no)  
 (organization running log)
  - (8) how well bottom plugged sand shell


DRILLERS REMARKS:



DEC 17 1975

If well telescopes please sketch and show depths.

GROUND LEVEL

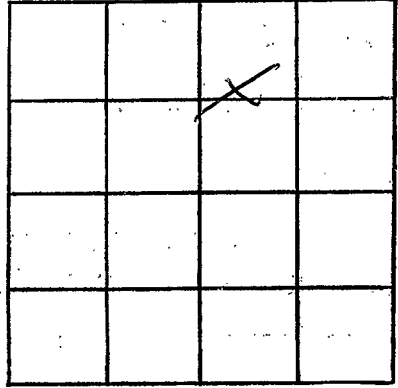

SECTION 22

Please indicate well location X.

ADDITIONAL INFORMATION

If more than one screen, show locations of each on sketch.