

Pike  
 C 2002  
 12-25-75

MISSISSIPPI  
 BOARD OF WATER COMMISSIONERS  
 416 North State Street  
 Jackson, Mississippi 39201

WATER WELL DRILLERS LOG


12-25 1975 *Fitzgerald Well Serv* *Pike*  
 date well completed firm name county well located

| LANDOWNER:   | description of formations encountered | from       | to         |
|--|---------------------------------------|------------|------------|
| <i>Chester Boyal</i>   |                                       |            |            |
| <i>R.R. Jones, miss</i><br>(mailing address)                                     | <i>Red sand</i>                       | <i>20</i>  | <i>80</i>  |
| WELL LOCATION:   | <i>Red gravel</i>                     | <i>80</i>  | <i>100</i> |
| sec. <i>29</i> T <i>4</i> N R <i>9</i> E<br>S W                                  | <i>Fine sand</i>                      | <i>100</i> | <i>145</i> |
| <i>2</i> miles <i>W</i> of <i>Amite</i><br>(distance) (direction) (nearest town) | <i>Coarse sand + gravel</i>           | <i>145</i> | <i>158</i> |
| WELL PURPOSE: <i>Home</i><br>(home, irrigation, municipal, industrial)           |                                       |            |            |
| WELL COMPLETION DATA:  |                                       |            |            |
| (1) diameter (inches) <i>4</i>   |                                       |            |            |
| (2) total depth (feet) <i>158</i>  |                                       |            |            |
| (3) static water level (feet) <i>128</i> above top of ground.                    |                                       |            |            |
| (4) casing <i>Plastic</i> , <i>150</i><br>(material) (depth)                     |                                       |            |            |
| <i>4</i> If telescope see back.<br>(size)  |                                       |            |            |
| (5) screen <i>8</i> , <i>150</i><br>(length) (depth to top)                      |                                       |            |            |
| <i>4</i> , <i>PVC</i><br>(size) (material)                                       |                                       |            |            |
| (6) pump <i>1/2</i> , <i>10</i><br>(HP) (yield gpm)                              |                                       |            |            |
| <i>Electric</i><br>(type power)  |                                       |            |            |
| (7) electric log <i>na</i><br>(yes or no)  |                                       |            |            |
| (organization running log)   |                                       |            |            |
| (8) how well bottom plugged <i>Sandstone</i>                                     |                                       |            |            |
| DRILLERS REMARKS:  |                                       |            |            |

REGISTERED  
 FEB 4 - 1976  
 MISS. BO. OF WATER COMM.

If well telescopes please sketch and show depths.

GROUND LEVEL

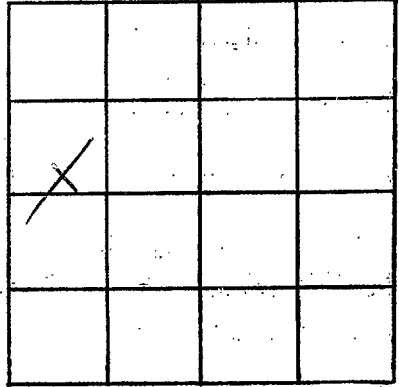

SECTION 29

Please indicate well location X.

ADDITIONAL INFORMATION

If more than one screen, show locations of each on sketch.