

PIKE
C 2003
1-10-76

MISSISSIPPI
BOARD OF WATER COMMISSIONERS
416 North State Street
Jackson, Mississippi 39201

WATER WELL DRILLERS LOG

Jan 10 1976 Reemwell Service Pike
date well completed firm name county well located

LANDOWNER:
Joe Jenkins
RT 1 Ruth
(mailing address)

description of formations encountered	from	to
<u>Red clay</u>	<u>0</u>	<u>12</u>
<u>Red sand</u>	<u>12</u>	<u>25</u>
<u>tan & gravel</u>	<u>25</u>	<u>80</u>
<u>sh. chert</u>	<u>80</u>	<u>105</u>
<u>hard gravel</u>	<u>105</u>	<u>125</u>


WELL LOCATION:
sec. 8 T. 4 N R. 9 E
1 miles north of Fiddlers
(distance) (direction) Cross town

WELL PURPOSE: home
(home, irrigation, municipal, industrial)

- WELL COMPLETION DATA:
- (1) diameter (inches) 4"
 - (2) total depth (feet) 125
 - (3) static water level (feet) 80 below top of ground.
 - (4) casing plastic bottom
(material) (depth)
 - (5) screen 6' 119
(length) (depth to top)
 - 4" plastic
(size) (material)
 - (6) pump 1/2 10
(HP) (yield gpm)
 - elct
(type power)
 - (7) electric log no
(yes or no)
 - (organization running log)


(8) how well bottom plugged
wooden plugs

DRILLERS REMARKS:
new house

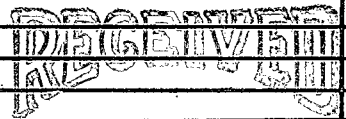

If well telescopes please sketch and show depths.

GROUND LEVEL

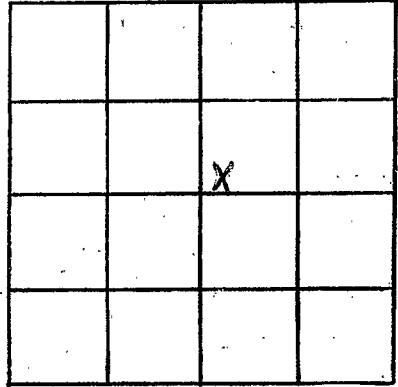

SECTION 8

Please indicate well location X.

ADDITIONAL INFORMATION

If more than one screen, show locations of each on sketch.