

**Pike**  
**C 2004**  
**1-14-76**

**MISSISSIPPI  
 BOARD OF WATER COMMISSIONERS**  
 416 North State Street  
 Jackson, Mississippi 39201


**WATER WELL DRILLERS LOG**

**1-14** date well completed    **1976**    **Fitzgerald Well Drilling** firm name    **Pike** county well located

LANDOWNER:	description of formations encountered	from	to
<u>Larry Morgan</u>	<u>Red Clay</u>	<u>0</u>	<u>20</u>
<u>R.B. Jones, Miss.</u> (mailing address)	<u>Red Sand</u>	<u>20</u>	<u>60</u>
<b>WELL LOCATION:</b>	<u>White &amp; Blue chalk</u>	<u>60</u>	<u>145</u>
sec. <u>23</u> T. <u>4</u> N. R. <u>9</u> E. <u>2</u> miles <u>E</u> of <u>Princeton</u> (distance) (direction) (nearest town)	<u>Coarse sand &amp; gravel</u>	<u>145</u>	<u>160</u>
<b>WELL PURPOSE:</b> <u>Home</u> (home, irrigation, municipal, industrial)			
<b>WELL COMPLETION DATA:</b>			
(1) diameter (inches) <u>4</u>			
(2) total depth (feet) <u>160</u>			
(3) static water level (feet) <u>65</u> below top of ground.			
(4) casing <u>PVC</u> , <u>152</u> (material) (depth)			
<u>4</u> if telescope see back. (size)			
(5) screen <u>8</u> , <u>152</u> (length) (depth to top)			
<u>4</u> , <u>PVC</u> (size) (material)			
(6) pump <u>1/2</u> , <u>10</u> (HP) (yield gpm)			
<u>elm</u> (type power)			
(7) electric log <u>no</u> (yes or no)			
(organization running log)			
(8) how well bottom plugged <u>Sand shale</u>			
<b>DRILLERS REMARKS:</b>	FEB 4 - 1976 MISS. BOARD OF WATER COMMISSIONERS		

If well telescopes please sketch and show depths.

GROUND LEVEL

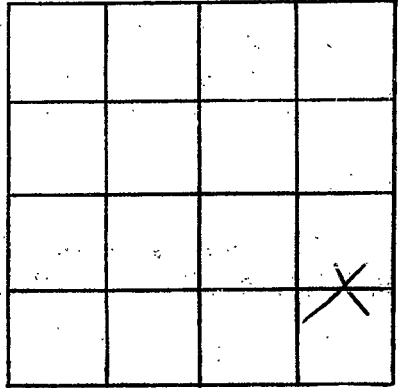

SECTION 23

Please indicate well location X.

ADDITIONAL INFORMATION

If more than one screen, show locations of each on sketch.