

Pike
C 2005
1-28-76

MISSISSIPPI
 BOARD OF WATER COMMISSIONERS
 416 North State Street
 Jackson, Mississippi 39201

WATER WELL DRILLERS LOG

1-28
 date well completed

134

76 Fitzgerald Wheel Service
 firm name


Piute
 county well located

LANDOWNER:	description of formations encountered	from	to
<u>Robin Nettles</u>			
<u>R.B. Jaynes, Miss.</u> (mailing address)	<u>Red clay</u>	<u>0</u>	<u>20</u>
	<u>Red gravel</u>	<u>20</u>	<u>80</u>
	<u>Red sand</u>	<u>80</u>	<u>120</u>
	<u>Coarse sand & gravel</u>	<u>120</u>	<u>133</u>
WELL LOCATION: sec. <u>2</u> T. <u>9</u> ^N S. R. <u>7</u> ^E W. <u>6</u> miles <u>N</u> of <u>Resdale</u> (distance) (direction) (nearest town)			
WELL PURPOSE: <u>Home</u> (home, irrigation, municipal, industrial)			
WELL COMPLETION DATA: (1) diameter (inches) <u>4</u> (2) total depth (feet) <u>133</u> (3) static water level (feet) <u>85</u> below top of ground. (4) casing <u>PVC</u> , <u>125</u> , (material) (depth) <u>4</u> if telescope see back. (size) (5) screen <u>8</u> , <u>125</u> (length) (depth to top) <u>4</u> , <u>PVC</u> (size) (material) (6) pump <u>1/2</u> , <u>10</u> (HP) (yield gpm) <u>Elec</u> (type power) (7) electric log <u>no</u> (yes or no) (organization running log) (8) how well bottom plugged <u>Sand Hook</u>			
DRILLERS REMARKS:			

MISS. BD. OF WATER COMMISSIONERS
 APR - 1976
 MISS. BD. OF WATER COMMISSIONERS

If well telescopes please sketch and show depths.

GROUND LEVEL

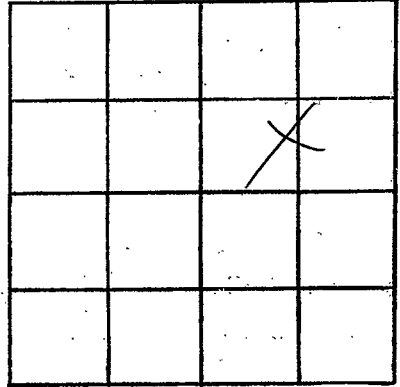

SECTION 2

Please indicate well location X.

ADDITIONAL INFORMATION

If more than one screen, show locations of each on sketch.