

Pike  
C 2000  
2-25-76

MISSISSIPPI  
 BOARD OF WATER COMMISSIONERS  
 416 North State Street  
 Jackson, Mississippi 39201

WATER WELL DRILLERS LOG

Feb 25 1976 Picus Well Service Pike  
 date well completed firm name county well located

LANDOWNER:  
Mr. Harold Young  
Rt. 1 Prith  
 (mailing address)

description of formations encountered	from	to
<u>Red clay</u>	<u>0</u>	<u>20</u>
<u>sand &amp; gravel</u>	<u>20</u>	<u>60</u>
<u>White Chalk</u>	<u>60</u>	<u>100</u>
<u>lumpy sand</u>	<u>100</u>	<u>115</u>
<u>sand &amp; per. gravel</u>	<u>115</u>	<u>136</u>


WELL LOCATION:  
 sec. 7 T. 4 N. R. 9 E. W. 8  
2 miles N-NW of Filders  
 (distance) (direction) (nearest town)

WELL PURPOSE: home  
 (home, irrigation, municipal, industrial)

- WELL COMPLETION DATA:
- (1) diameter (inches) 4"
  - (2) total depth (feet) 136
  - (3) static water level (feet) 100 below top of ground.
  - (4) casing plastic, bottom  
 (material) (depth)
  - if telescope see back.  
 (size)
  - (5) screen 6' 130  
 (length) (depth to top)
  - 4" plastic  
 (size) (material)
  - (6) pump 1/2 HP 8  
 (HP) (yield gpm)
  - split  
 (type power)
  - (7) electric log no  
 (yes or no)
  - (organization running log)


(8) how well bottom plugged  
wooden plug

DRILLERS REMARKS:  
easy well

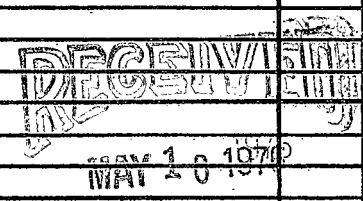

If well telescopes please sketch and show depths.

GROUND LEVEL

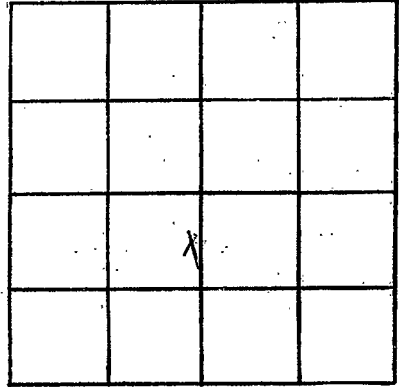

SECTION 7

Please indicate well location X.

ADDITIONAL INFORMATION

If more than one screen,  
show locations of each on sketch.