

PIKE
 C 2007
 2-27-76

MISSISSIPPI
 BOARD OF WATER COMMISSIONERS
 416 North State Street
 Jackson, Mississippi 39201


WATER WELL DRILLERS LOG

27 Feb 1976 J-T-Corngton Pike
 date well completed firm name county well located

LANDOWNER:	description of formations encountered	from	to
Laron Hollaway James Miss (mailing address)	clay chert sand	0 25 50	25 50 75
WELL LOCATION: sec. 11 T 4 N R 9 E 4 miles NE of Broadalox			
WELL PURPOSE: (home, irrigation, municipal, industrial)			
WELL COMPLETION DATA:			
(1) diameter (inches) 4			
(2) total depth (feet) 114			
(3) static water level (feet) 90 below top of ground.			
(4) casing (material) PL (depth) 108			
(size) if telescope see back.			
(5) screen (length) 6 (depth to top) 108			
(size) 4 (material) PL			
(6) pump (HP) 1/2 (yield gpm) 8			
(type power) gas			
(7) electric log (yes or no)			
(organization running log)			
(8) how well bottom plugged road			
DRILLERS REMARKS:	APR 29 1976 MISS. Bd. OF WATER COMM.		

If well telescopes please sketch and show depths.

GROUND LEVEL

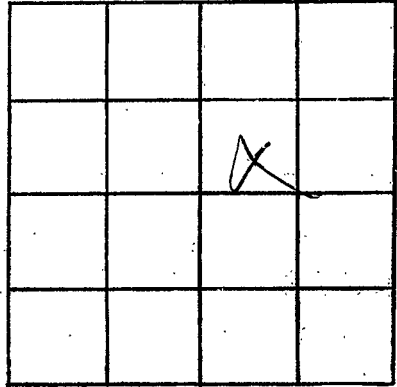

SECTION 11

Please indicate well location X.

ADDITIONAL INFORMATION

If more than one screen, show locations of each on sketch.