

PIKE
 C 2008
 3-26-76

MISSISSIPPI
 BOARD OF WATER COMMISSIONERS
 416 North State Street
 Jackson, Mississippi 39201

WATER WELL DRILLERS LOG

March 26 1976 *News Well Ser* *Pike*
 date well completed firm name county well located

LANDOWNER:
Alice Hanks
Mt. Summit
 (mailing address)

description of formations encountered	from	to
<i>Red Clay</i>	<i>0</i>	<i>18</i>
<i>Red Sand & gravel</i>	<i>18</i>	<i>30</i>
<i>Red Chalk</i>	<i>30</i>	<i>75</i>
<i>lumpy sand</i>	<i>75</i>	<i>135</i>
<i>sand & gravel</i>	<i>135</i>	<i>160</i>

WELL LOCATION:
 sec. *18* T *4* N R *7* E
13 miles *ESE* of *Eddies*
 (distance) (direction) (nearest town)

WELL PURPOSE: *None*
 (home, irrigation, municipal, industrial)

- WELL COMPLETION DATA:
- (1) diameter (inches) *4"*
 - (2) total depth (feet) *160*
 - (3) static water level (feet) *90* below top of ground.
 - (4) casing *plastic*, *bottom*
 (material) (depth)
 - if telescope see back.
 (size)
 - (5) screen *6"*, *157'*
 (length) (depth to top)
 - 11"*, *plastic*
 (size) (material)
 - (6) pump *1/2 Sub.*, *10*
 (HP) (yield gpm)
 - select*
 (type power)
 - (7) electric log *no*
 (yes or no)
 - (organization running log)


(8) how well bottom plugged
Wooden Plug

DRILLERS REMARKS:
2" well mustie

MAR 29 1976

If well telescopes please sketch and show depths.

GROUND LEVEL

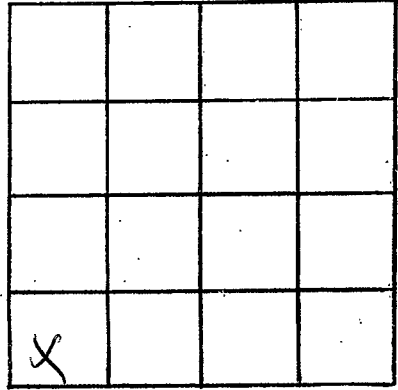

SECTION 18

Please indicate well location X.

ADDITIONAL INFORMATION

If more than one screen, show locations of each on sketch.