

make
 C 2011
 7/14/76

MISSISSIPPI
 BOARD OF WATER COMMISSIONERS
 416 North State Street
 Jackson, Mississippi 39201

13U

WATER WELL DRILLERS LOG

July 14 1976 *Reeves Well Dr* *Pike*
 date well completed firm name county well located

LANDOWNER:
Johanie Johnson
Rt. 1
Jays
 (mailing address)

description of formations encountered	from	to
<i>Red Clay</i>	<i>0</i>	<i>22</i>
<i>Red sand</i>	<i>22</i>	<i>60</i>
<i>Sandy gravel</i>	<i>60</i>	<i>86</i>
<i>pink Chalk</i>	<i>86</i>	<i>125</i>
<i>Red gravel & sand</i>	<i>125</i>	<i>135</i>

WELL LOCATION:
 sec *23* T *4* N R *9* E
2 miles *east* of *puccala*
 (distance) (direction) (nearest town)

WELL PURPOSE: *Trailer*
 (home, irrigation, municipal, industrial)

WELL COMPLETION DATA:

(1) diameter (inches) *4"*

(2) total depth (feet) *135*

(3) static water level (feet) *75* below above top of ground.

(4) casing *plastic bottom*
 (material) (depth)

1 If telescope see back.
 (size)

(5) screen *6"* *129*
 (length) (depth to top)

1/2" *plastic*
 (size) (material)

(6) pump *3/4* *8*
 (HP) (yield gpm)

elect
 (type power)

(7) electric log *no*
 (yes or no)

(organization running log)

(8) how well bottom plugged
at water plug


DRILLERS REMARKS:

RECEIVED

OCT 22 1976

If well telescopes please sketch and show depths.

GROUND LEVEL

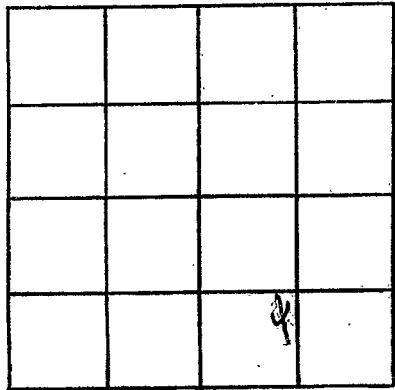

SECTION 23

Please indicate well location X.

ADDITIONAL INFORMATION

If more than one screen, show locations of each on sketch.