

Like
C 2013
9-1-76

MISSISSIPPI
 BOARD OF WATER COMMISSIONERS
 416 North State Street
 Jackson, Mississippi 39201

134

WATER WELL DRILLERS LOG


9-1 1976 Fluorobond Lead Pike
 date well completed firm name county well located

LANDOWNER:	description of formations encountered	from	to
<u>Rate Demaree</u>			
<u>R.R. Jayess</u> (mailing address)	<u>Red clay</u>	<u>0</u>	<u>20</u>
	<u>Red sand</u>	<u>20</u>	<u>80</u>
	<u>Red gravel</u>	<u>80</u>	<u>120</u>
	<u>Coarse sand gravel</u>	<u>120</u>	<u>139</u>
WELL LOCATION:			
sec. <u>11</u> T. <u>4</u> N. R. <u>9</u> E			
<u>2 1/2</u> miles <u>N</u> of <u>Preedale</u> (distance) (direction) (nearest town)			
WELL PURPOSE: (home, irrigation, municipal, industrial)			
WELL COMPLETION DATA:			
(1) diameter (inches) <u>4"</u>			
(2) total depth (feet) <u>139</u>			
(3) static water level (feet) <u>85</u> below top of ground.			
(4) casing <u>PVC</u> <u>131</u> (material) (depth)			
<u>2</u> If telescope see back. (size)			
(5) screen <u>8</u> <u>131</u> (length) (depth to top)			
<u>4</u> <u>PVC</u> (size) (material)			
(6) pump <u>1/2</u> <u>10</u> (HP) (yield gpm)			
<u>Electric</u> (type power)			
(7) electric log <u>No</u> (yes or no)			
<u>Fluorobond Lead</u> (organization running log)			
(8) how well bottom plugged <u>Lead floor</u>			
DRILLERS REMARKS:			

RECEIVED
 OCT 18 1976
 MISSISSIPPI BOARD OF WATER COMMISSIONERS

If well telescopes please sketch and show depths.

GROUND LEVEL

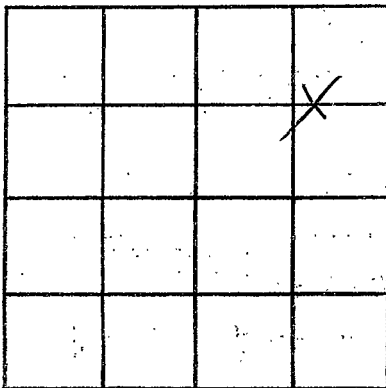

SECTION 11

Please indicate well location X.

ADDITIONAL INFORMATION

If more than one screen, show locations of each on sketch.