

Pike
C 2014
10-6-76

MISSISSIPPI
 BOARD OF WATER COMMISSIONERS
 416 North State Street
 Jackson, Mississippi 39201


WATER WELL DRILLERS LOG

10-6 1976 Fitzgerald Well Serv Pike
 date well completed firm name county well located

LANDOWNER:	description of formations encountered	from	to
<u>D.P. Duraway</u>			
<u>R.R. Summit Miss.</u> (mailing address)	<u>Red clay</u>	<u>0</u>	<u>20</u>
	<u>Red gravel</u>	<u>20</u>	<u>120</u>
	<u>Red ground</u>	<u>120</u>	<u>150</u>
	<u>Coarse sand & gravel</u>	<u>150</u>	<u>160</u>
WELL LOCATION:			
sec. <u>29</u> T <u>4</u> (N) R. <u>9</u> (E)			
<u>9</u> miles <u>NE</u> of <u>McComb</u> (distance) (direction) (nearest town)			
WELL PURPOSE: <u>Home</u> (home, irrigation, municipal, industrial)			
WELL COMPLETION DATA:			
(1) diameter (inches) <u>4</u>			
(2) total depth (feet) <u>160</u>			
(3) static water level (feet) <u>120</u> below above top of ground.			
(4) casing <u>PVC</u> , <u>152</u> , (material) (depth) <u>4</u> If telescope see back. (size)			
(5) screen <u>8</u> , <u>152</u> (length) (depth to top) <u>4</u> , <u>PVC</u> (size) (material)			
(6) pump <u>1/2</u> , <u>10</u> (HP) (yield gpm) <u>Electric</u> (type power)			
(7) electric log <u>No</u> (yes or no) (organization running log)			
(8) how well bottom plugged <u>Sand plug</u>			
DRILLERS REMARKS:			

If well telescopes please sketch and show depths.

GROUND LEVEL

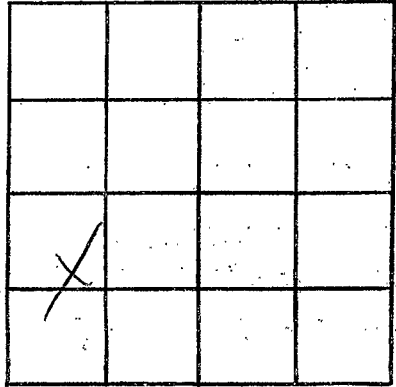

SECTION 29

Please indicate well location 'X'.

ADDITIONAL INFORMATION

If more than one screen,
show locations of each on sketch.