

Pike  
C 2015  
10-10-76

MISSISSIPPI  
 BOARD OF WATER COMMISSIONERS  
 416 North State Street  
 Jackson, Mississippi 39201

WATER WELL DRILLERS LOG


10-10 1976 Fitzgerald Well Service Pike  
 date well completed firm name county well located

LANDOWNER:	description of formations encountered	from	to
<u>Rabbie Fisher</u>			
<u>R.B. Ruth, Miss.</u> (mailing address)	<u>Red clay</u>	<u>0</u>	<u>20</u>
	<u>Red sand</u>	<u>20</u>	<u>80</u>
	<u>Coarse sand &amp; gravel</u>	<u>80</u>	<u>92</u>
WELL LOCATION: sec. <u>6</u> T. <u>4</u> N. R. <u>9</u> E S W			
<u>2</u> miles <u>S</u> of <u>Shady Grove</u> (distance) (direction) (nearest town)			
WELL PURPOSE: (home, irrigation, municipal, industrial) <u>Home</u>			
WELL COMPLETION DATA:			
(1) diameter (inches) <u>4</u>			
(2) total depth (feet) <u>91</u>			
(3) static water level (feet) <u>22</u> below above top of ground.			
(4) casing <u>PVC</u> , <u>83</u> , (material) (depth)			
<u>4</u> (size) If telescope see back.			
(5) screen <u>8</u> , <u>83</u> (length) (depth to top)			
<u>4</u> , <u>PVC</u> (size) (material)			
(6) pump <u>1/2</u> , <u>10</u> (HP) (yield gpm)			
<u>Ch</u> (type power)			
(7) electric log <u>No</u> (yes or no)			
(organization running log)			
(8) how well bottom plugged <u>Small hole</u>			
DRILLERS REMARKS:			

**RECEIVED**  
 DEC 23 1976

If well telescopes please sketch and show depths.

GROUND LEVEL

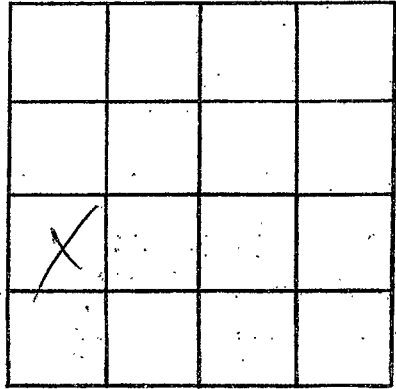

SECTION 6

Please indicate well location X.

ADDITIONAL INFORMATION

If more than one screen,  
show locations of each on sketch.